

JWA MARK-UP
14 OCT 2011
STUDIO STRATEGY

'QUIET' STUDIO

'CAD ENABLED' STUDIOS
> PERIMETER SEATING
> FIXED PC'S X 16
> SLIDER (CHECK SEAT NUMBERS)

'QUIET' STUDIOS

CONNECTION?


HALL STUDIO
> INFORMAL STUDY
> NON-BOOKABLE

'ACTIVE' STUDIO (CATALYST)

TERRACE STUDIO

'QUIET' STUDIO

'ACTIVE' STUDIOS
> EXHIBITION MODE (ALL OPEN)
> BREAKOUT MODE (SLIDERS CLOSED, HALL EDGE OPEN)
> SEMINAR MODE (ALL CLOSED)
> PAIRED MODE (2 SLIDERS OPEN)

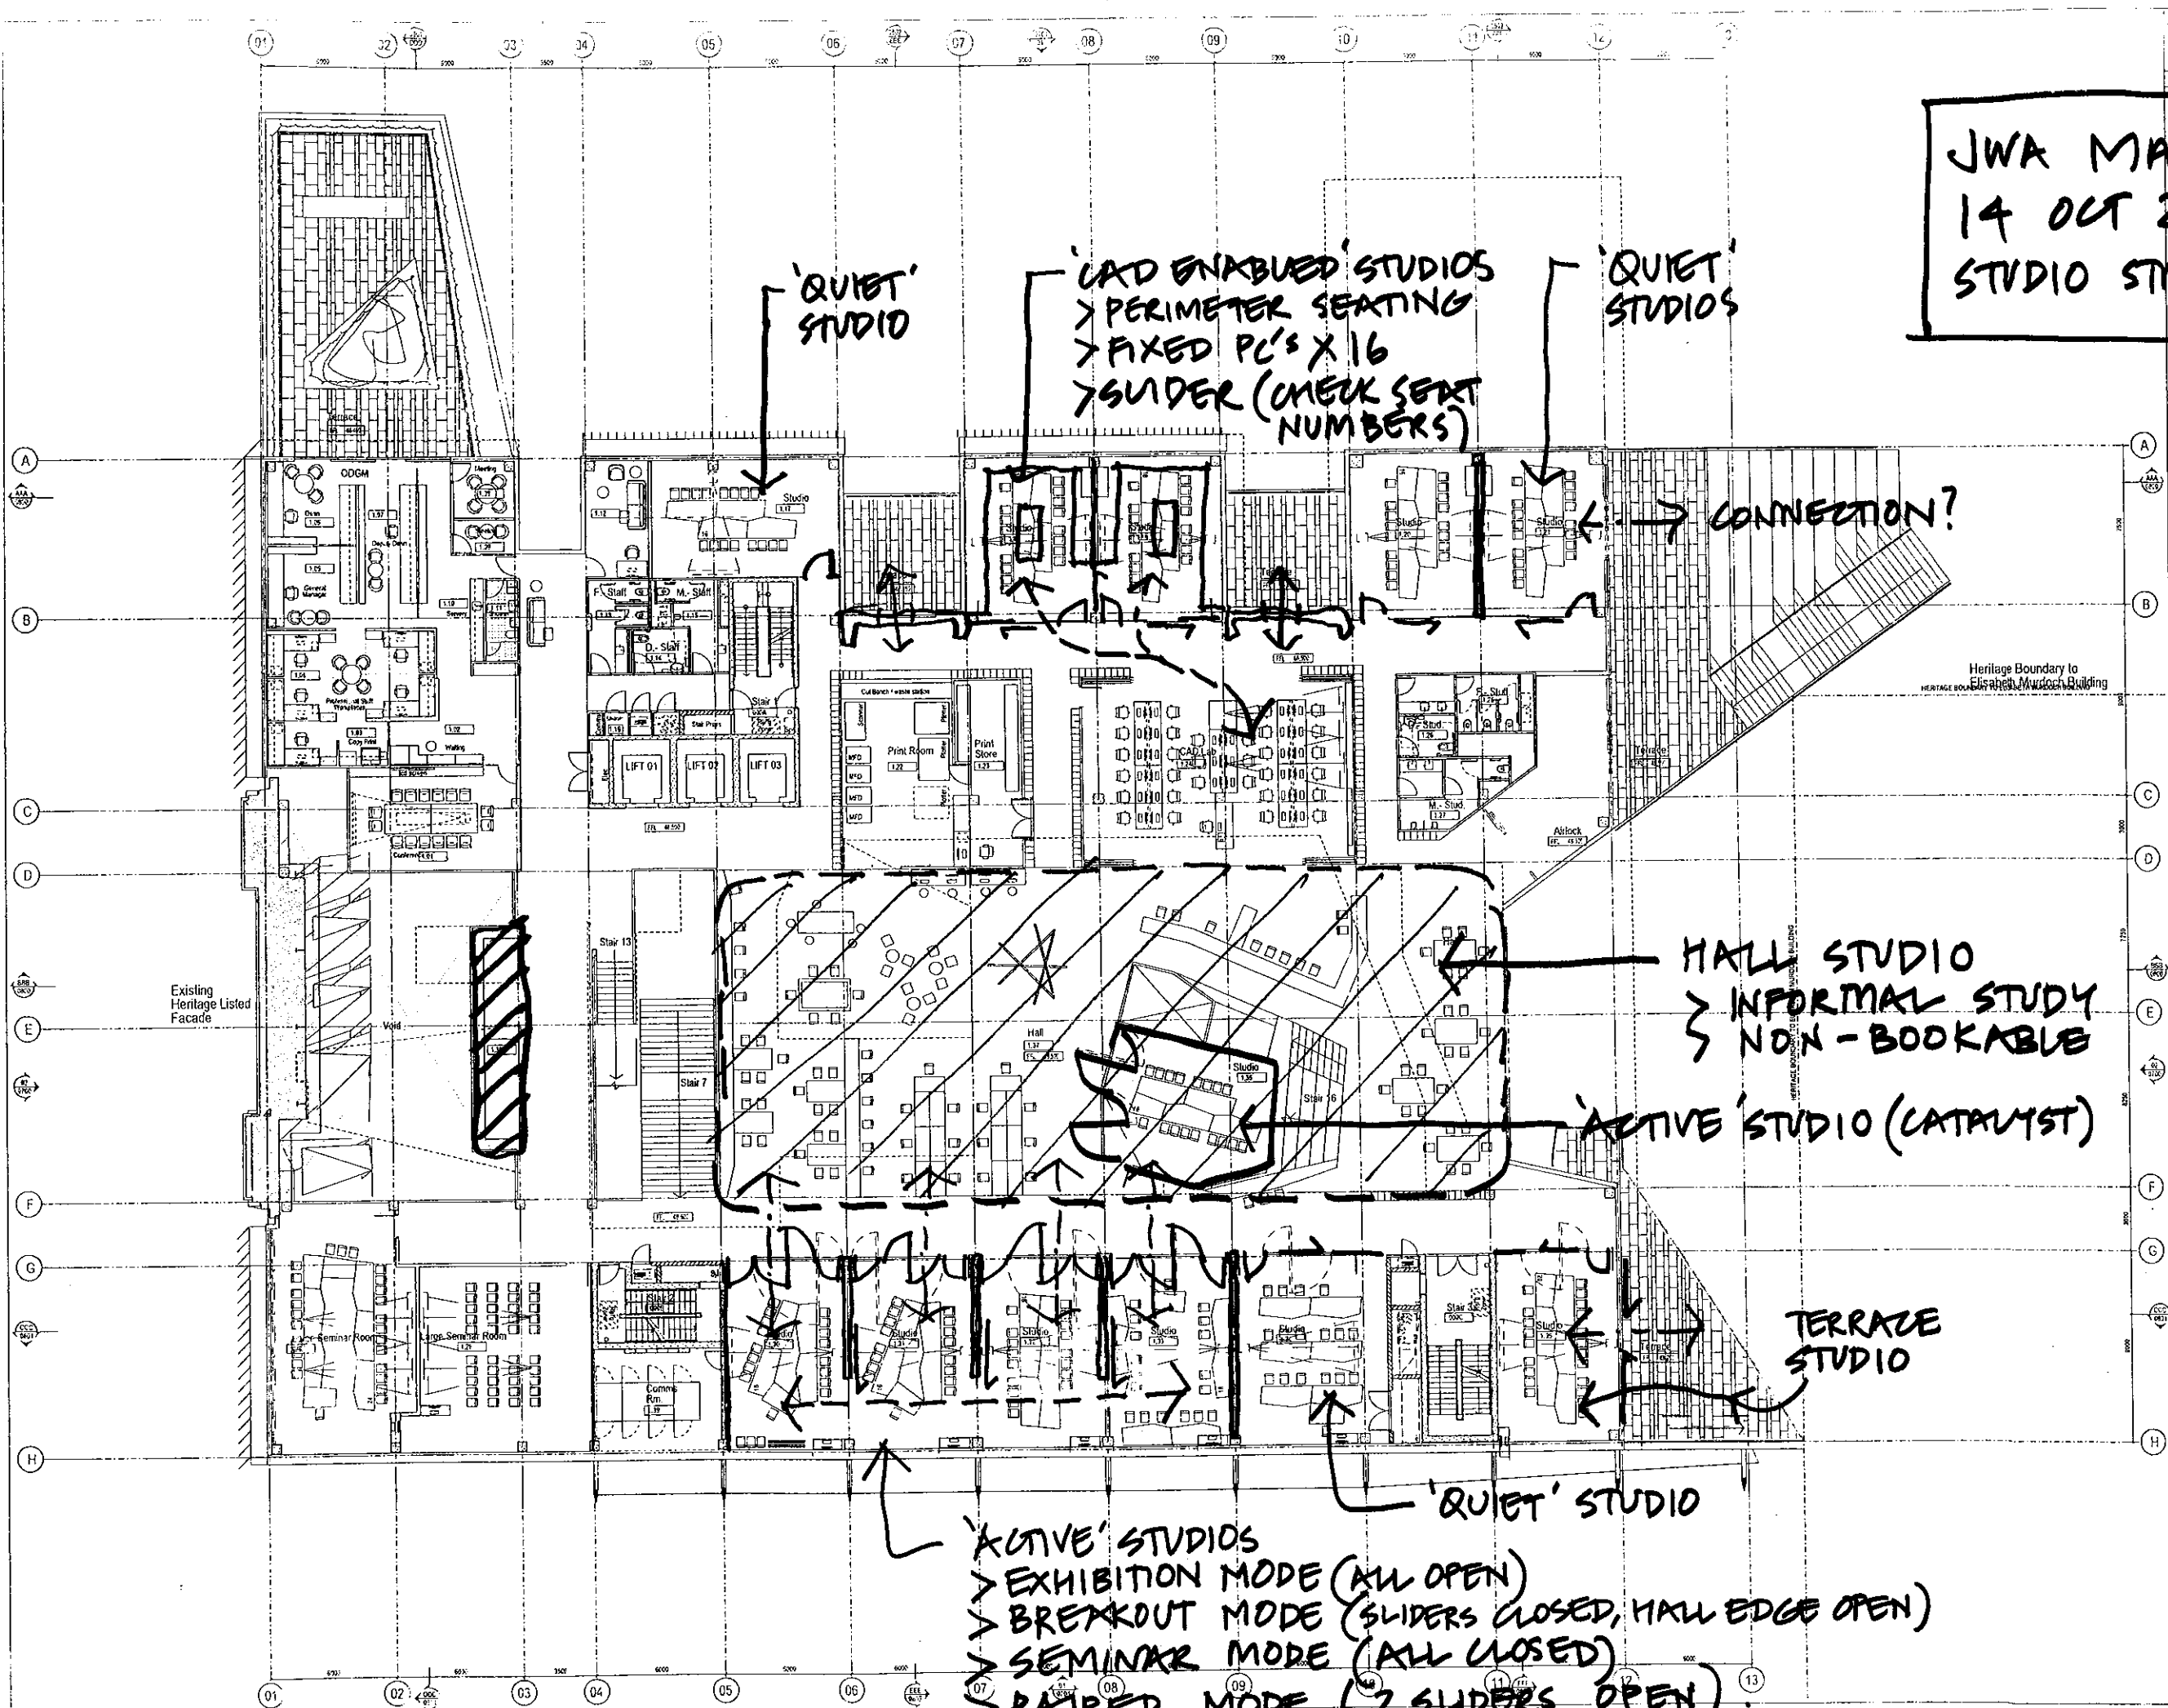

General Notes

Heritage Boundary to Elisabeth Murdoch Building

Rev	Date	Description	By	Appr
01	09/10/11	PRELIMINARY DD		

NADAAA

John Wardle Architects

© 2011 John Wardle Architects
Level 10, 180 Russell Street, Melbourne Victoria 3000 Australia
Tel: +613 9654 8100 www.johnwardlearchitects.com

Client: University of Melbourne
Parkville Campus

Project: Faculty of Architecture
Building and Planning

Title: GENERAL ARRANGEMENT
LEVEL 01 FLOOR PLAN - LO

Project No.	0915	Scale	1:100 @ A0 1:200 @ A1
Drawing No.	AR1002	Revision	01

Drawn: AR1002 Date: 09/10/11

FILE NAME: P:\0915\1 - 180 Russell Street Building\0915\AR1002.dwg

PRELIMINARY ISSUE

JWK MARK-UP
14 OCT 2011
STUDIO STRATEGY

WORK IN PROGRESS

'LARGE' STUDIO

'QUIET' STUDIOS
> SEMINAR MODE
> PAIRED MODE
(OPERABLE WALL)

DOORS?
SUSPENDED STUDIO
(CATALYST)

'QUIET' STUDIOS

HATCHED AREAS
NEED TO BE
FOR SMALL
GROUPS OF
STUDENTS,
SKY 3 TO 6,
TO DO COLLABORATIVE
WORK. FINAL
LOCATIONS TBC.


'CAD ENABLED' STUDIO
7 FIXED PC'S X 16
> SLIDER (CHECK SEAT NUMBERS)

'QUIET' STUDIOS.
> NO SLIDERS BETWEEN

STANDARD ARCHITECTURAL DRAWING CONVENTIONS

General Notes

Heritage Boundary to
Elizabeth Murdoch Building

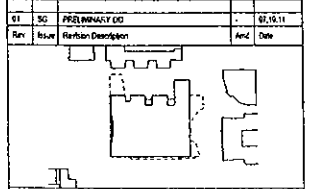

NADAAA
NADAAA
1200 Riverside Drive
Brooklyn, NY 11218 USA
Tel: +1 718 462 1212
Fax: +1 718 462 1217
Email: nadaaa@nadaaa.com

John Wardle Architects
© 2011 John Wardle Architects
Level 10, 180 Russell Street Melbourne Victoria 3000 Australia
Tel: +61 3 9058 8700 www.johnwardle.com.au

Client: University of Melbourne
Parkville Campus
Project: Faculty of Architecture
Building and Planning


The GENERAL ARRANGEMENT
LEVEL 02 FLOOR PLAN - LUZ

Project No. 0913 Scale: 1:500 G.A.C.
Drawing No. AR1003 Revision: 01
Date: May 2011 Drawn: C.A.C. Checked: C.A.C. Created: C.A.C.


PRELIMINARY ISSUE

2

JWA MARK-UP
14 OCT 2011
STUDIO STRATEGY

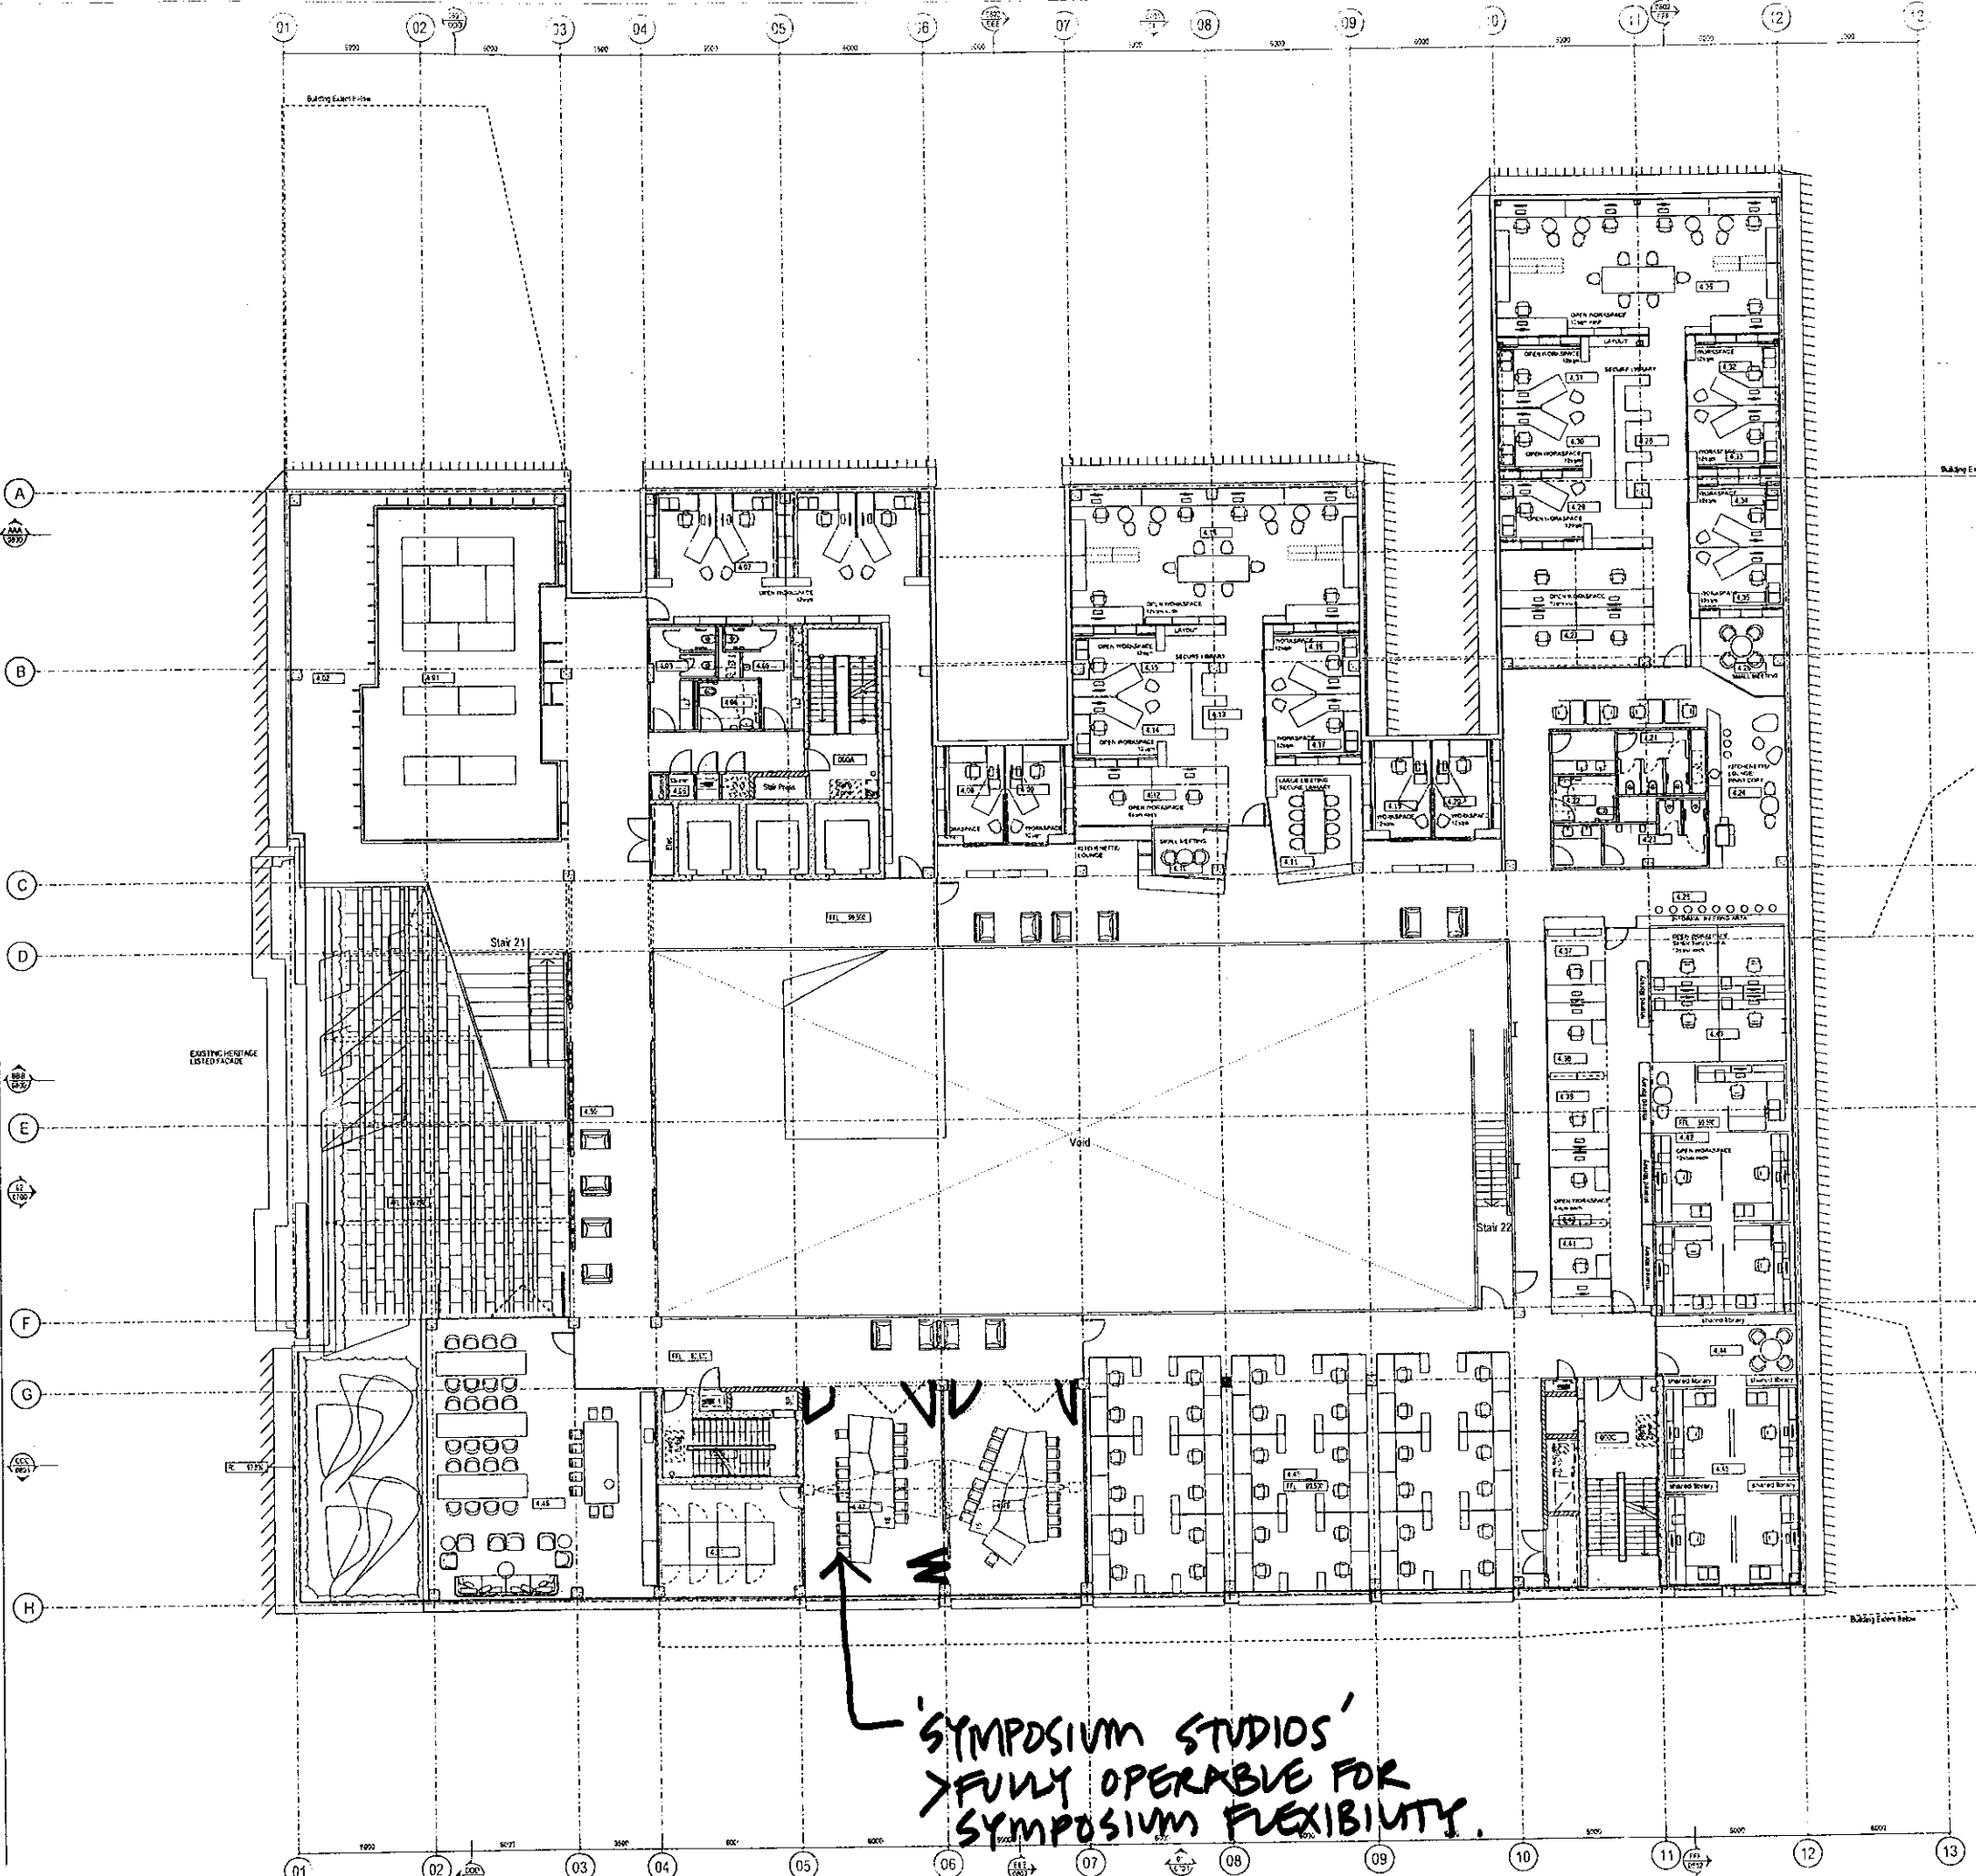

GENERAL NOTE
THIS DRAWING IS A PRELIMINARY ISSUE AND IS NOT TO BE USED FOR CONSTRUCTION OR FOR ANY OTHER PURPOSE WITHOUT THE WRITTEN PERMISSION OF JOHN WARDLE ARCHITECTS.

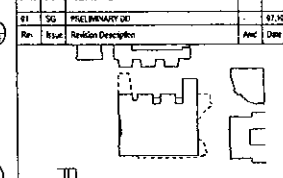

NADAAA
NADAAA
100, Franklin
Street No. 2
Melbourne
VIC 3000
Australia
Tel: +61 3 9654 0100
Fax: +61 3 9654 0101
Email: nadaaa@nadaaa.com.au

John Wardle Architects
© 2011 John Wardle Architects
Level 10, 180 Russell Street, Melbourne Victoria
Tel: +61 3 9654 0100
www.johnwardle.com.au

Client: University of Melbourne
Parkville Campus
Project: Faculty of Architecture
Building and Planning

The GENERAL ARRANGEMENT LEVEL 4 FLOOR PLAN - L04	
Project No. 0913	Scale: 1:500 @ A4 1:250 @ A3
Drawing No. AR1005	Revision: 01
Date: Nov 2011	Drawn: Co-Ord: Chk:
FILENAME: P:\0909\0913\1005\Architecture\Building\Production\CAD\Drawings\Level 4 L04.rvt	
PRELIMINARY ISSUE	

3

4

HALL

CORRIDOR

EXTEND INTO
HALL / CIRCULATION
ZONE

ACCESS
CONTROL
DOOR

EXHIBITION
DISPLAY
(PIN-UP)

COLLABORATIVE
LEARNING
LAYOUT
(GROUPS OF
4-6)

WRITABLE
GLASS
SURFACE

PINUP
SURFACE

PIN UP
SURFACE
ON DOOR
BOTH
SIDES.


TUTORS
STATION

UNIVERSITY STANDARD
WHITE PAINTED
PROJECTION SURFACE
(2.4M WIDTH IMAGE)
OR SPECIAL PIN UP
PROJECTION SURFACE


- BAG ALLOVES
- MODEL SETDOWN
- AV & PC STATION.

ACTIVE STUDIO - BREAKOUT

1500X750MM TABLES
2250X750MM TABLES

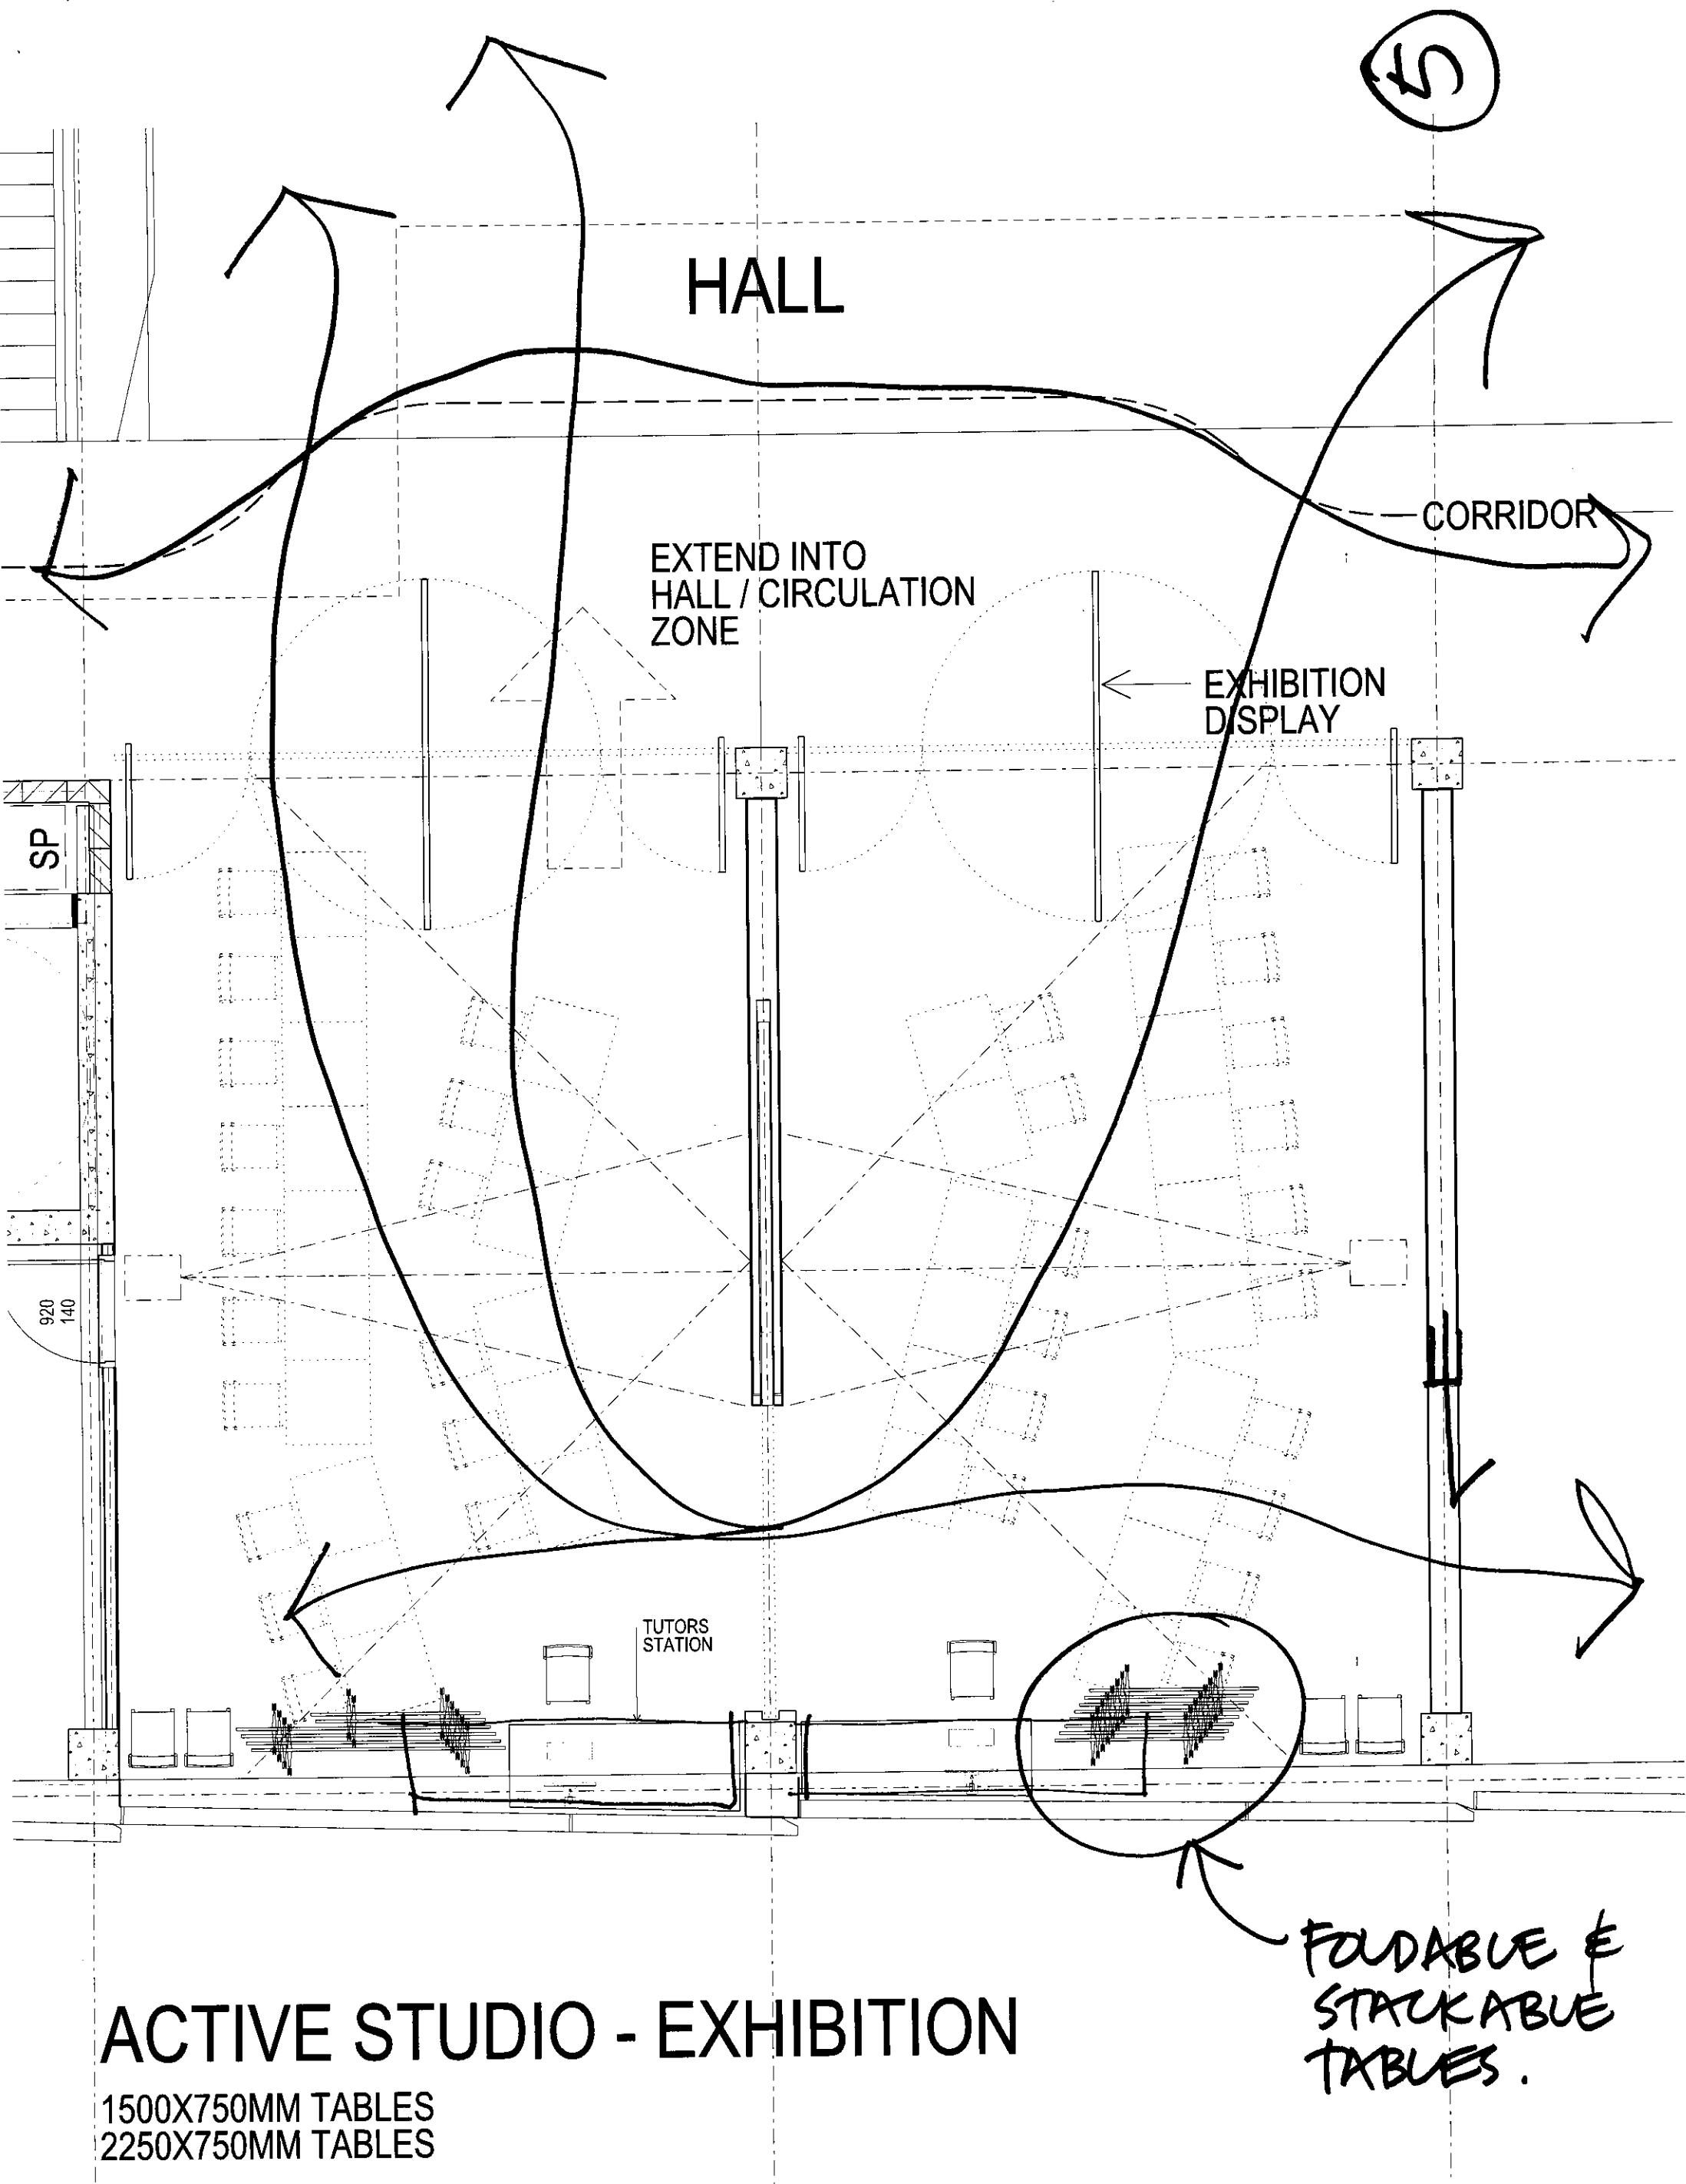


2

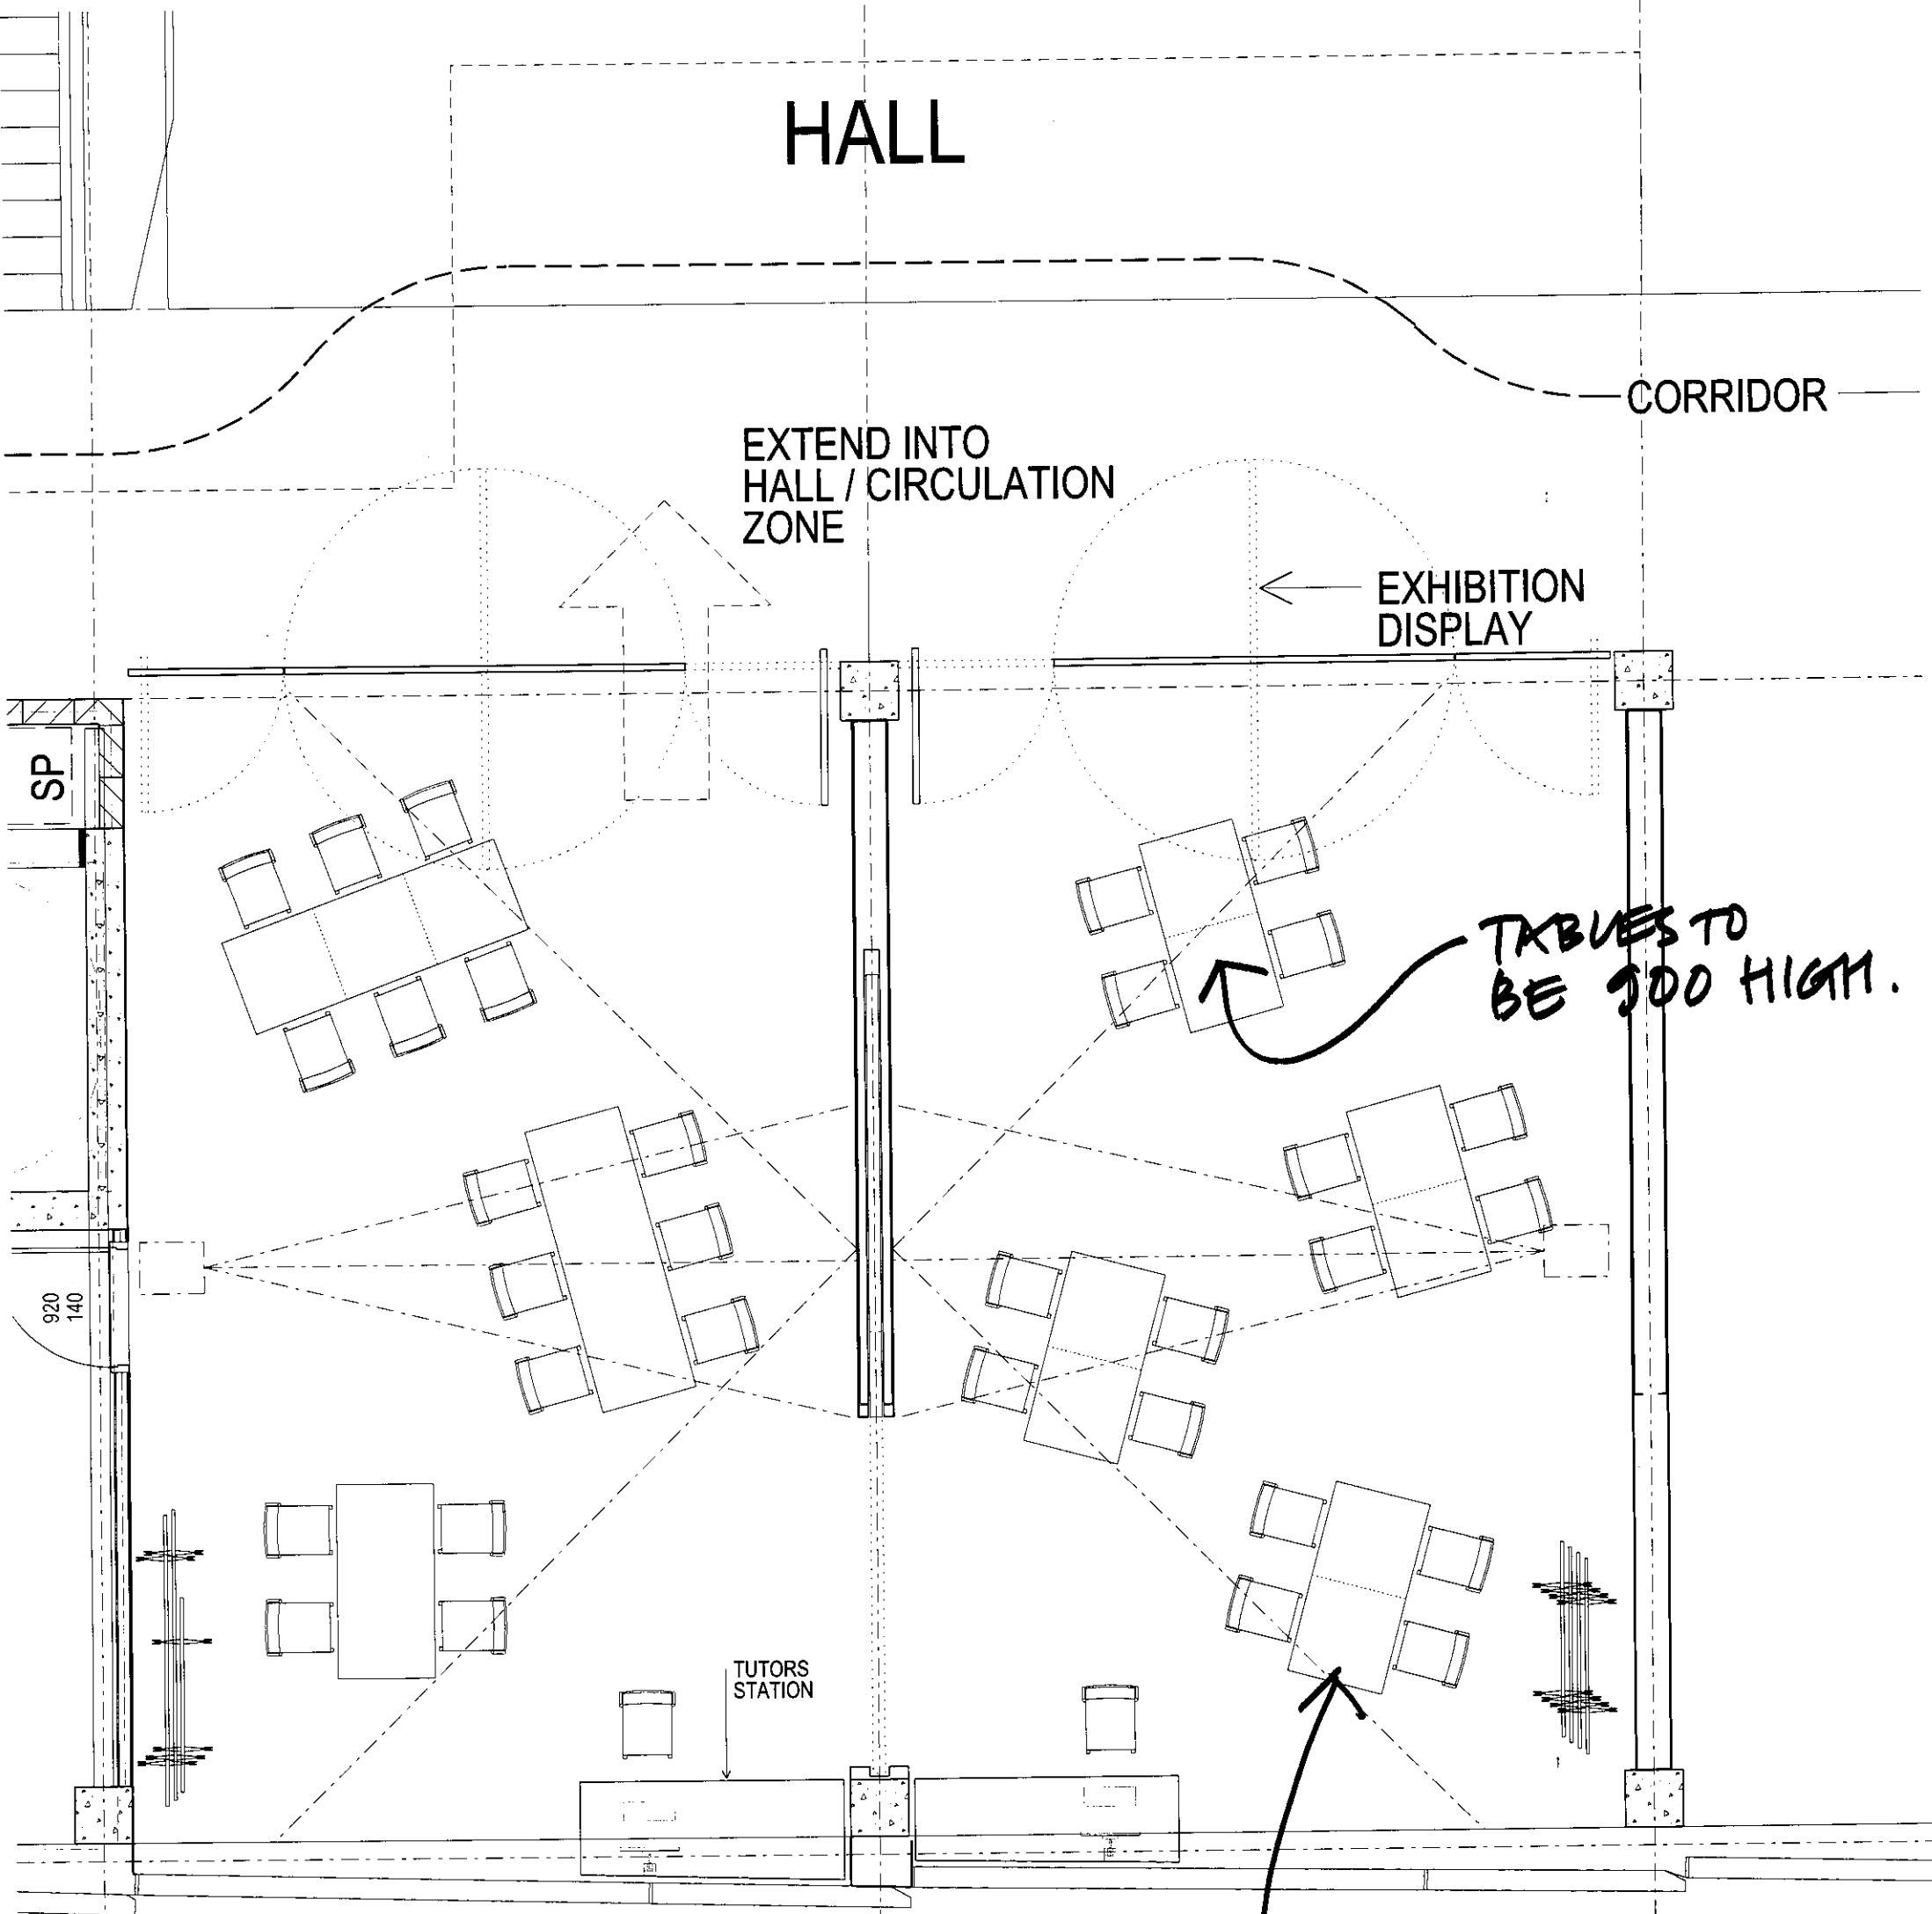

ACTIVE STUDIO - GROUPS

1500X750MM TABLES
2250X750MM TABLES



GROUPWORK
ON 750 DEEP
TABLES.

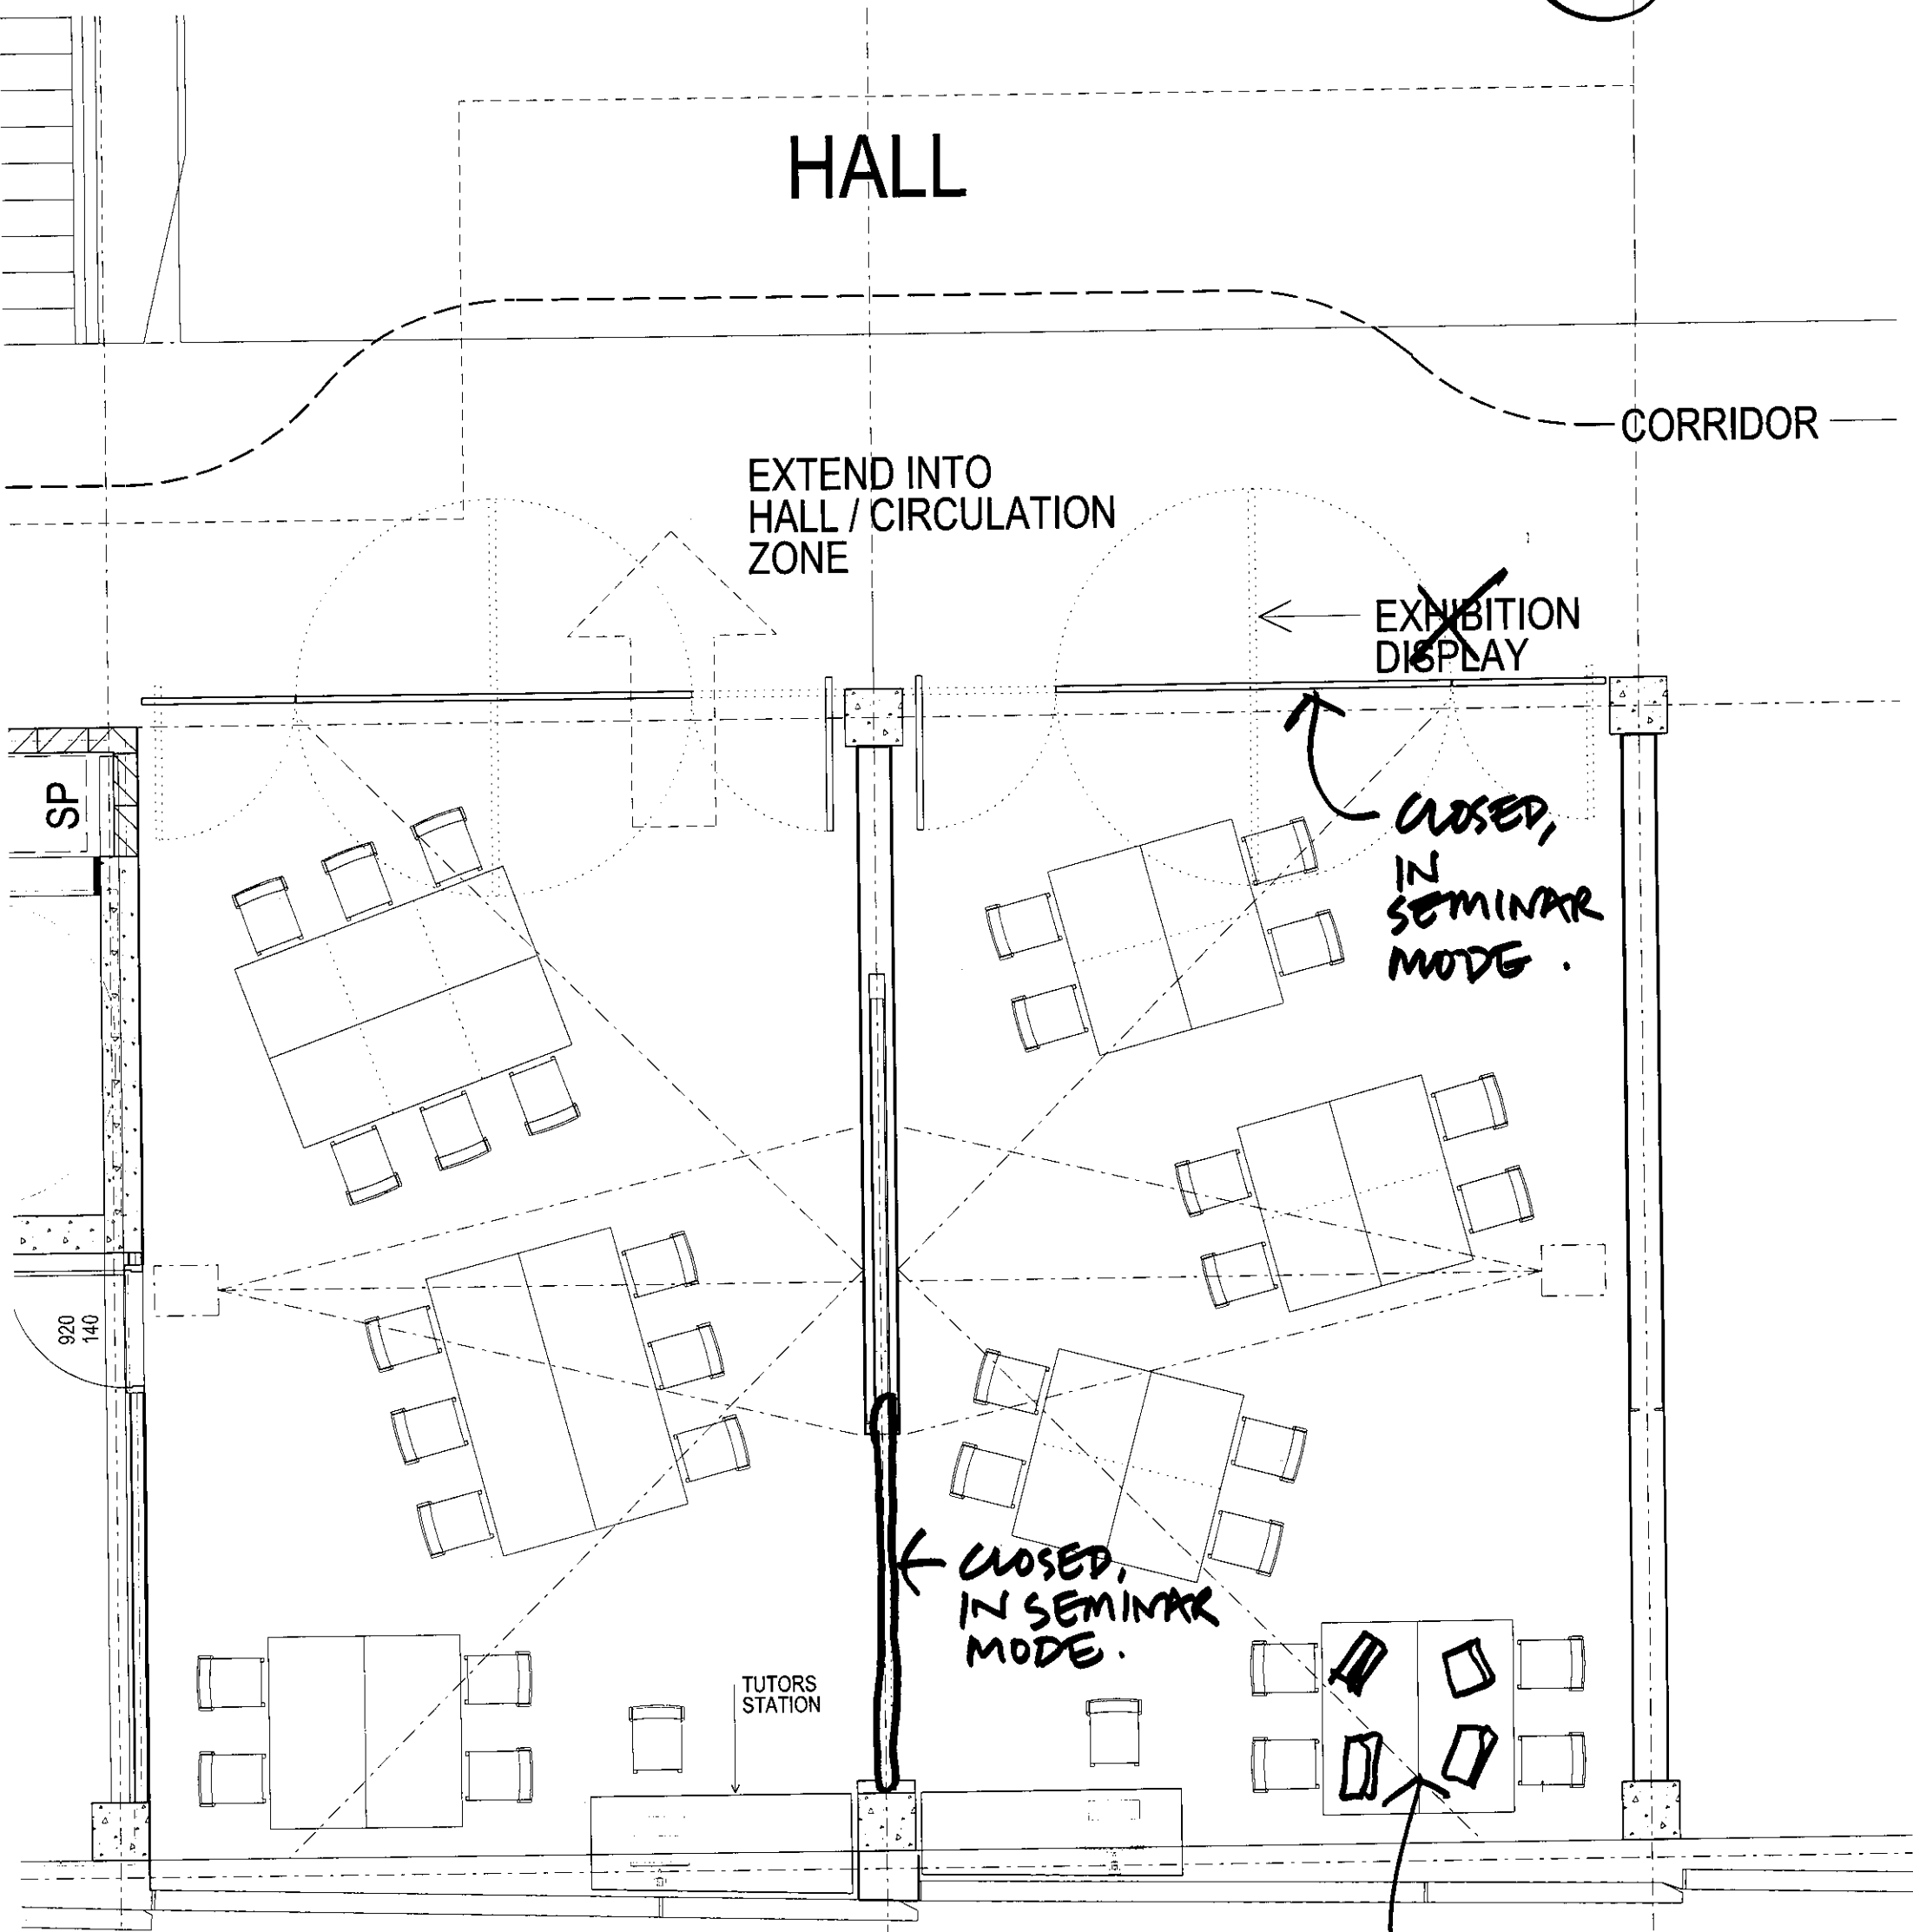

ACTIVE STUDIO - LAPTOP GROUPS

1500X750MM TABLES
2250X750MM TABLES

GROUPWORK
WITH SPACE
FOR LAPTOPS.

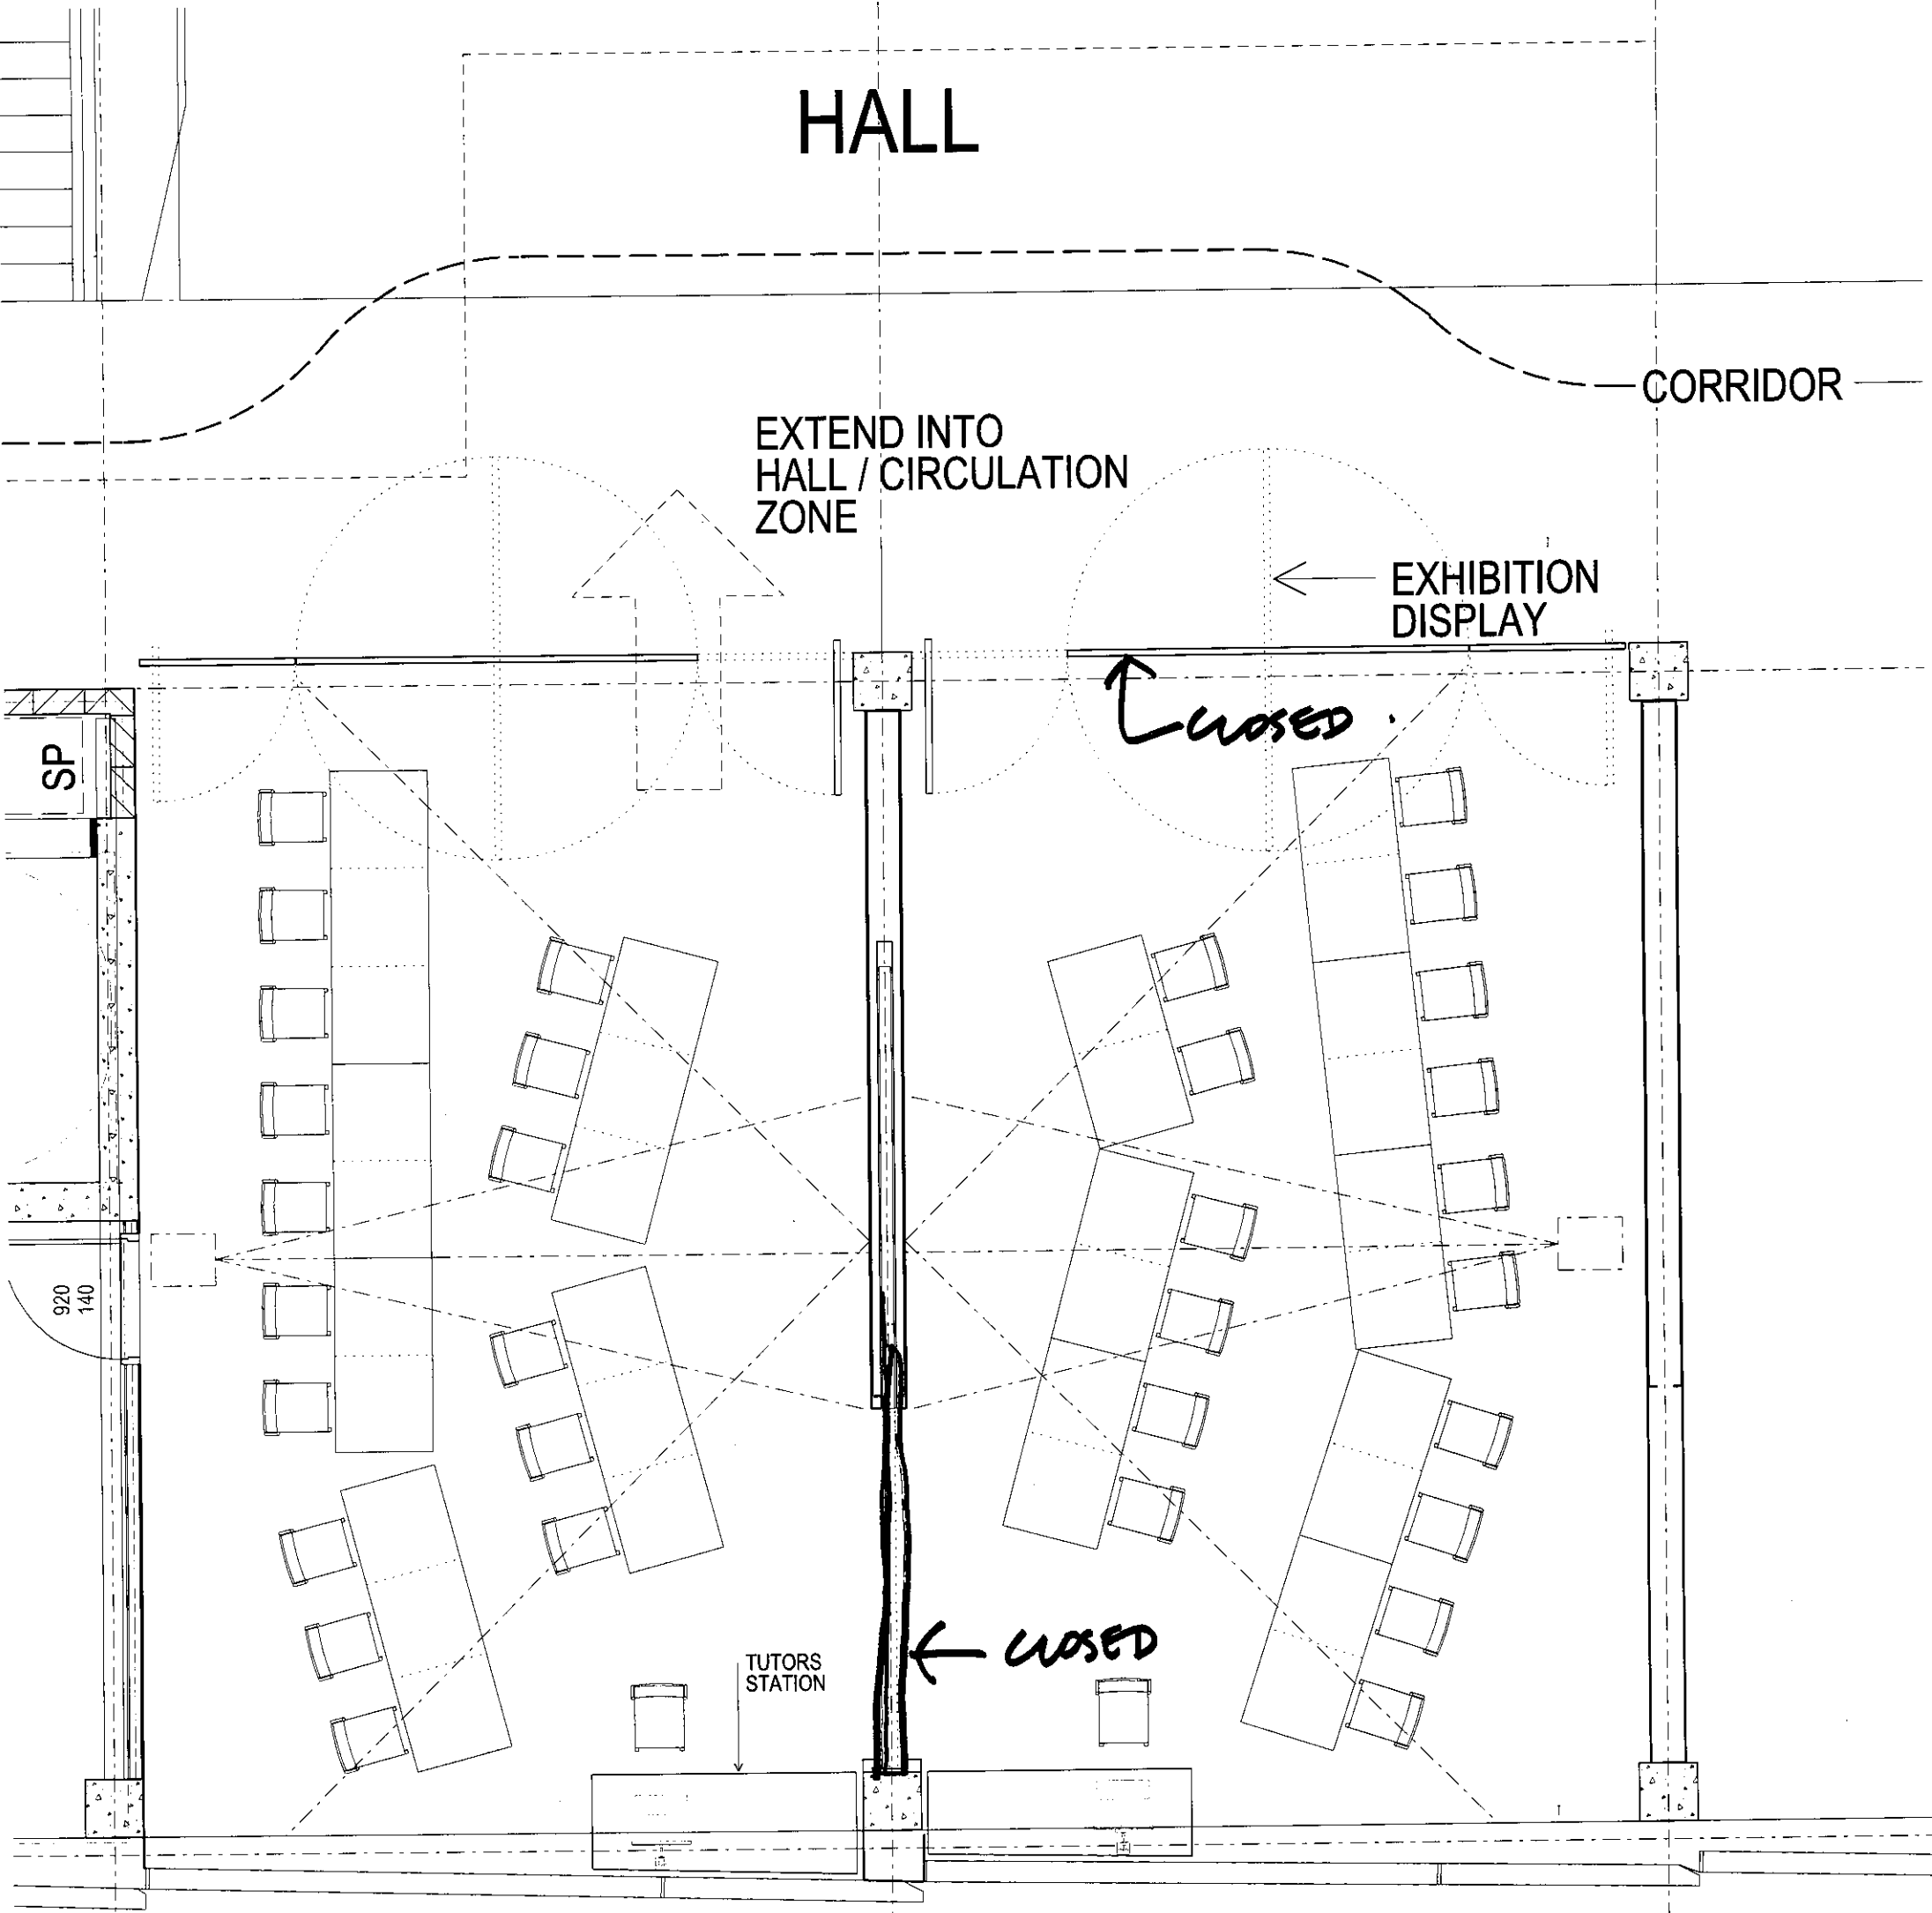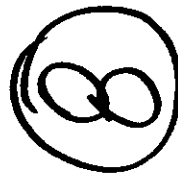


ACTIVE STUDIO - TUTORIAL

1500X750MM TABLES
2250X750MM TABLES




9

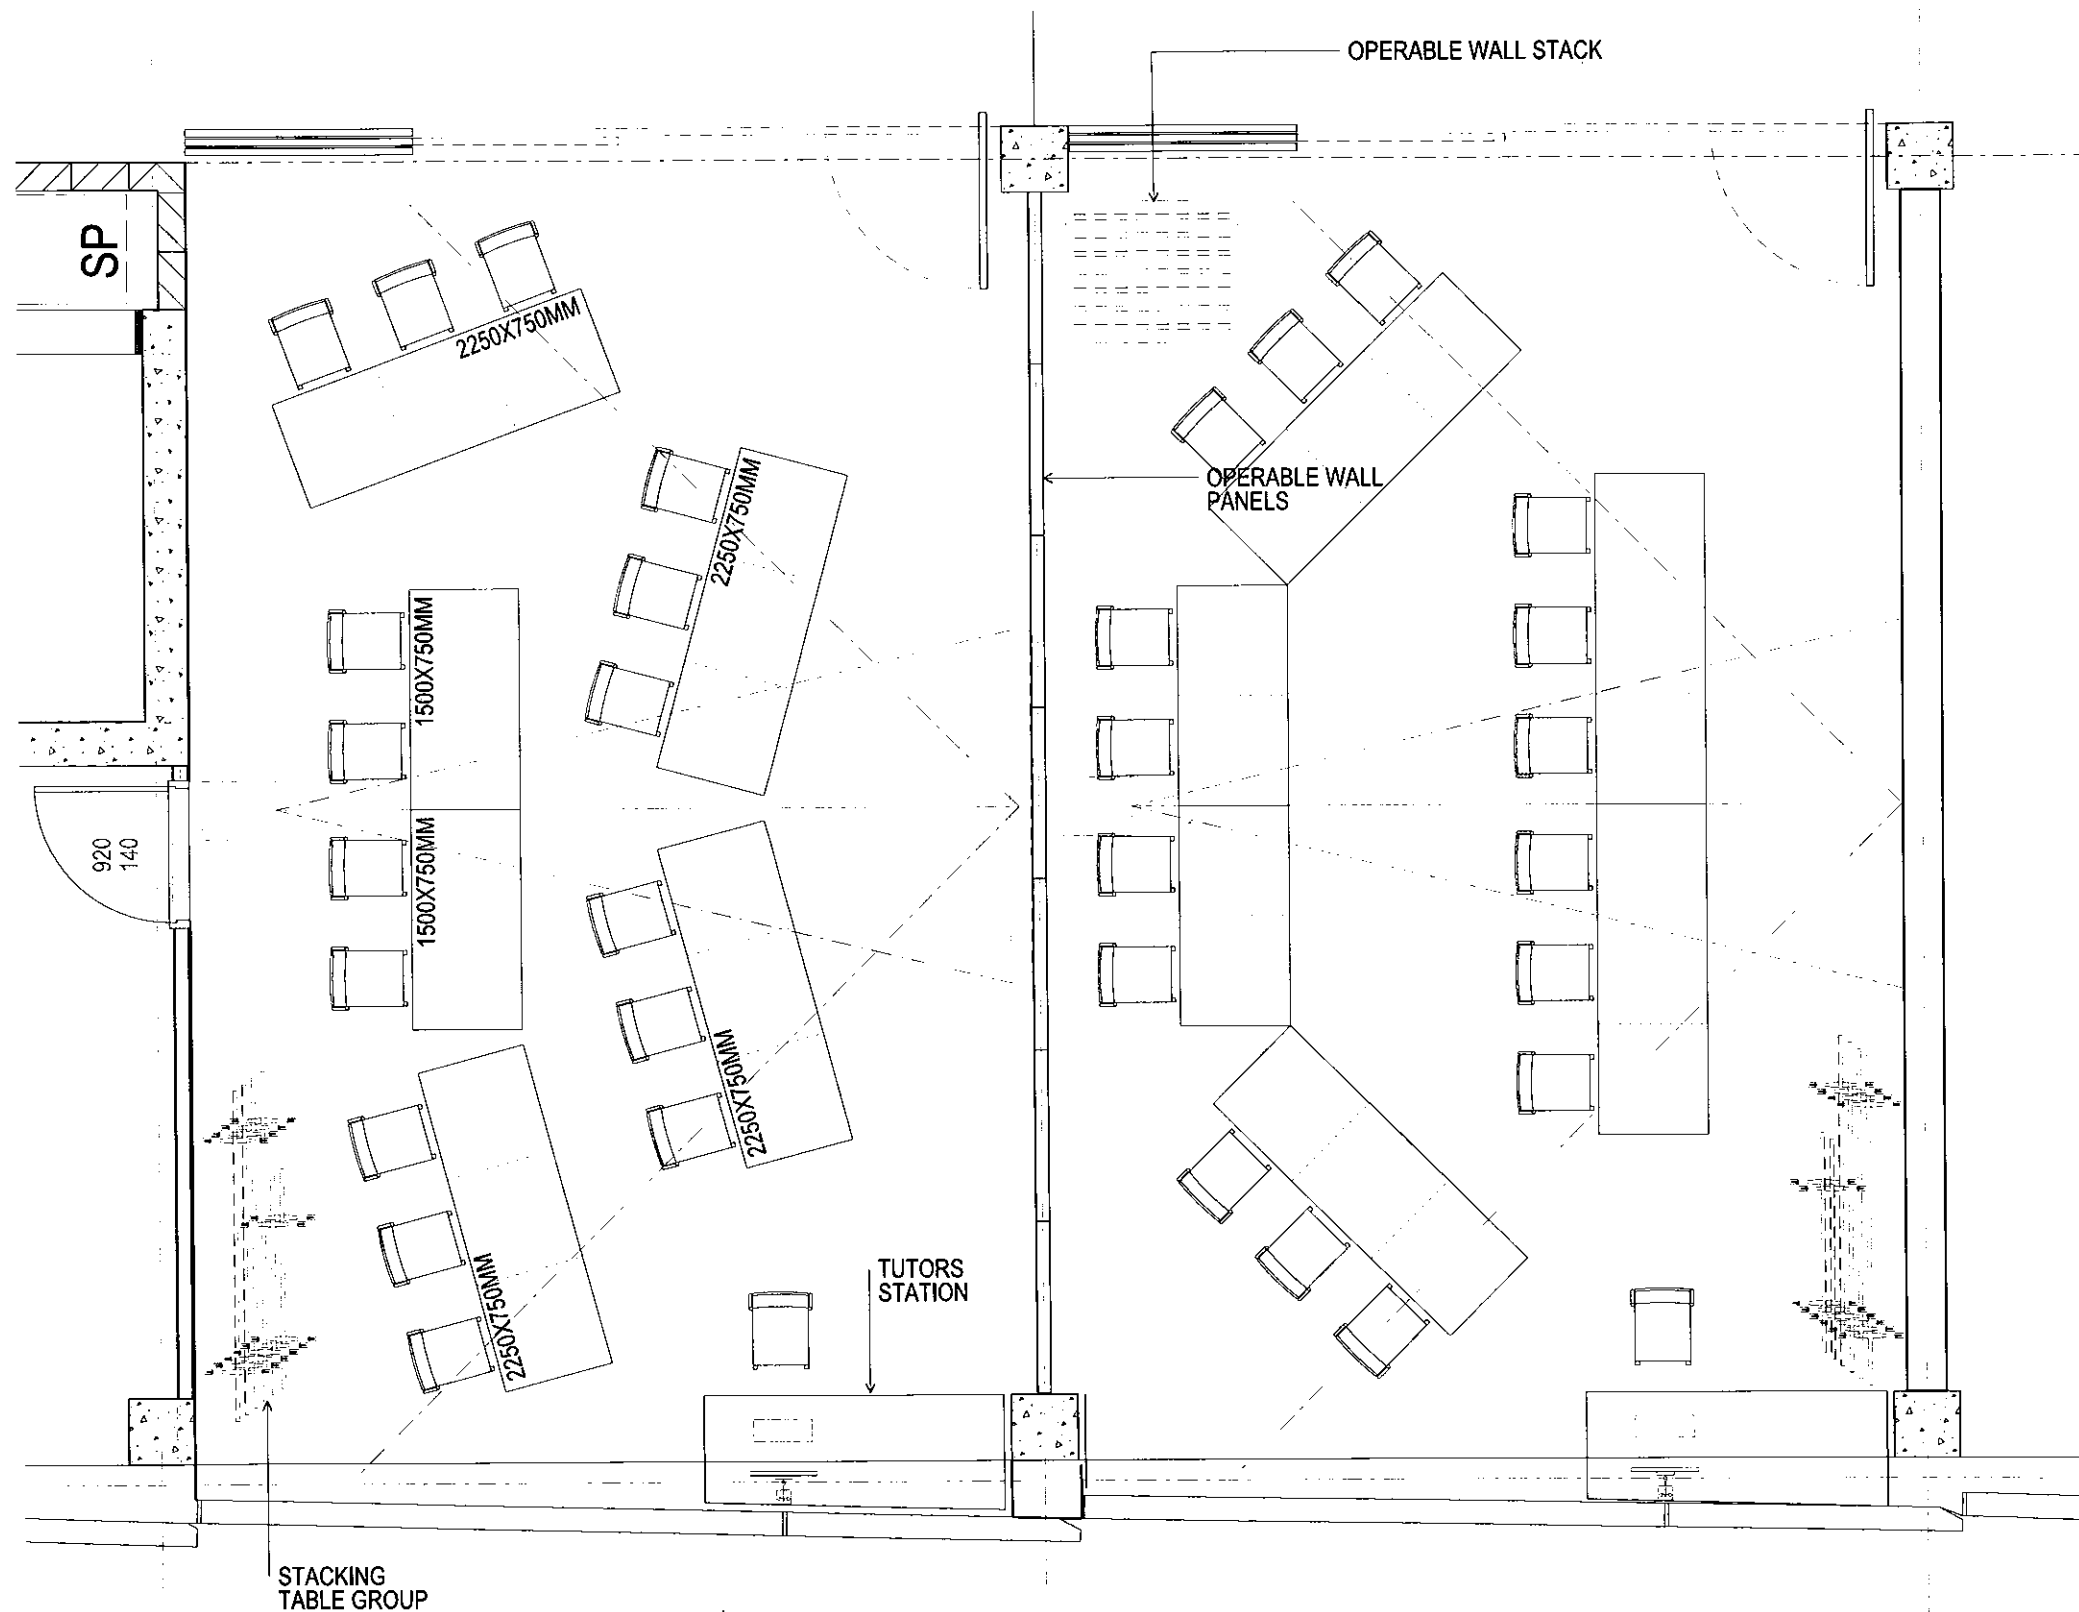


**2250X750MM / 1500X750MM TABLES
OPERABLE WALL**

10

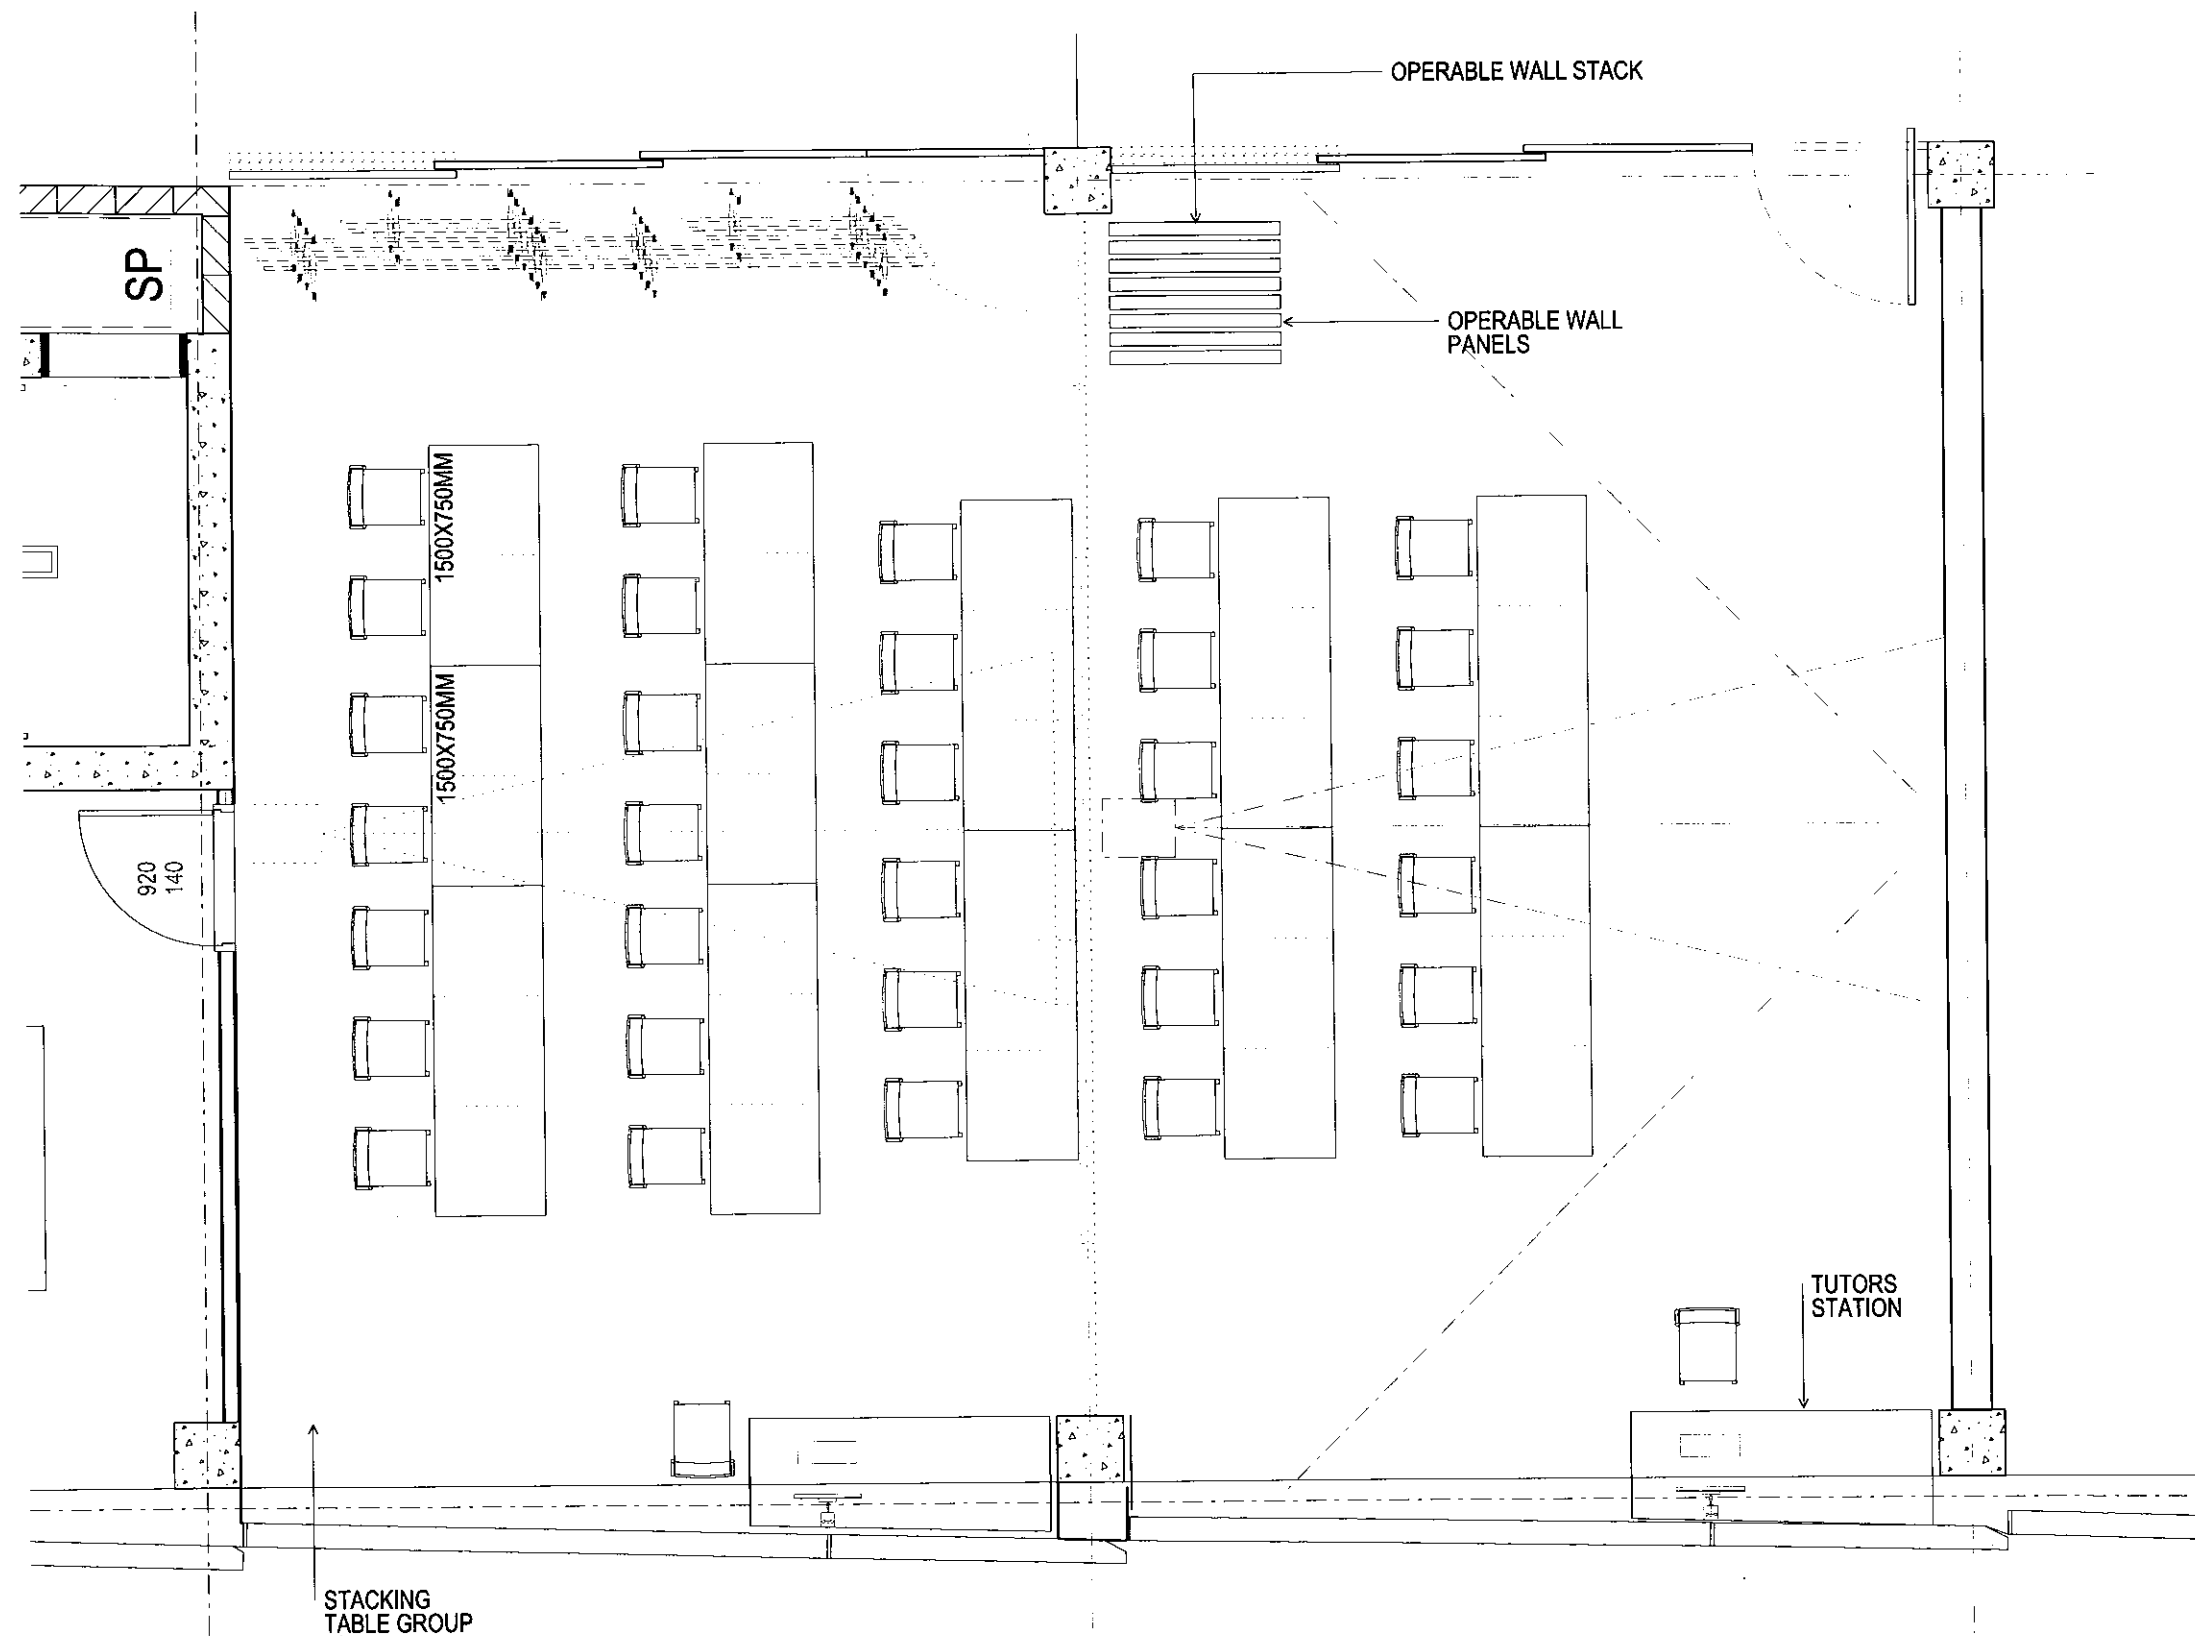


2250X750 / 1500X750MM TABLES
OPERABLE WALL - OPEN MODE

11

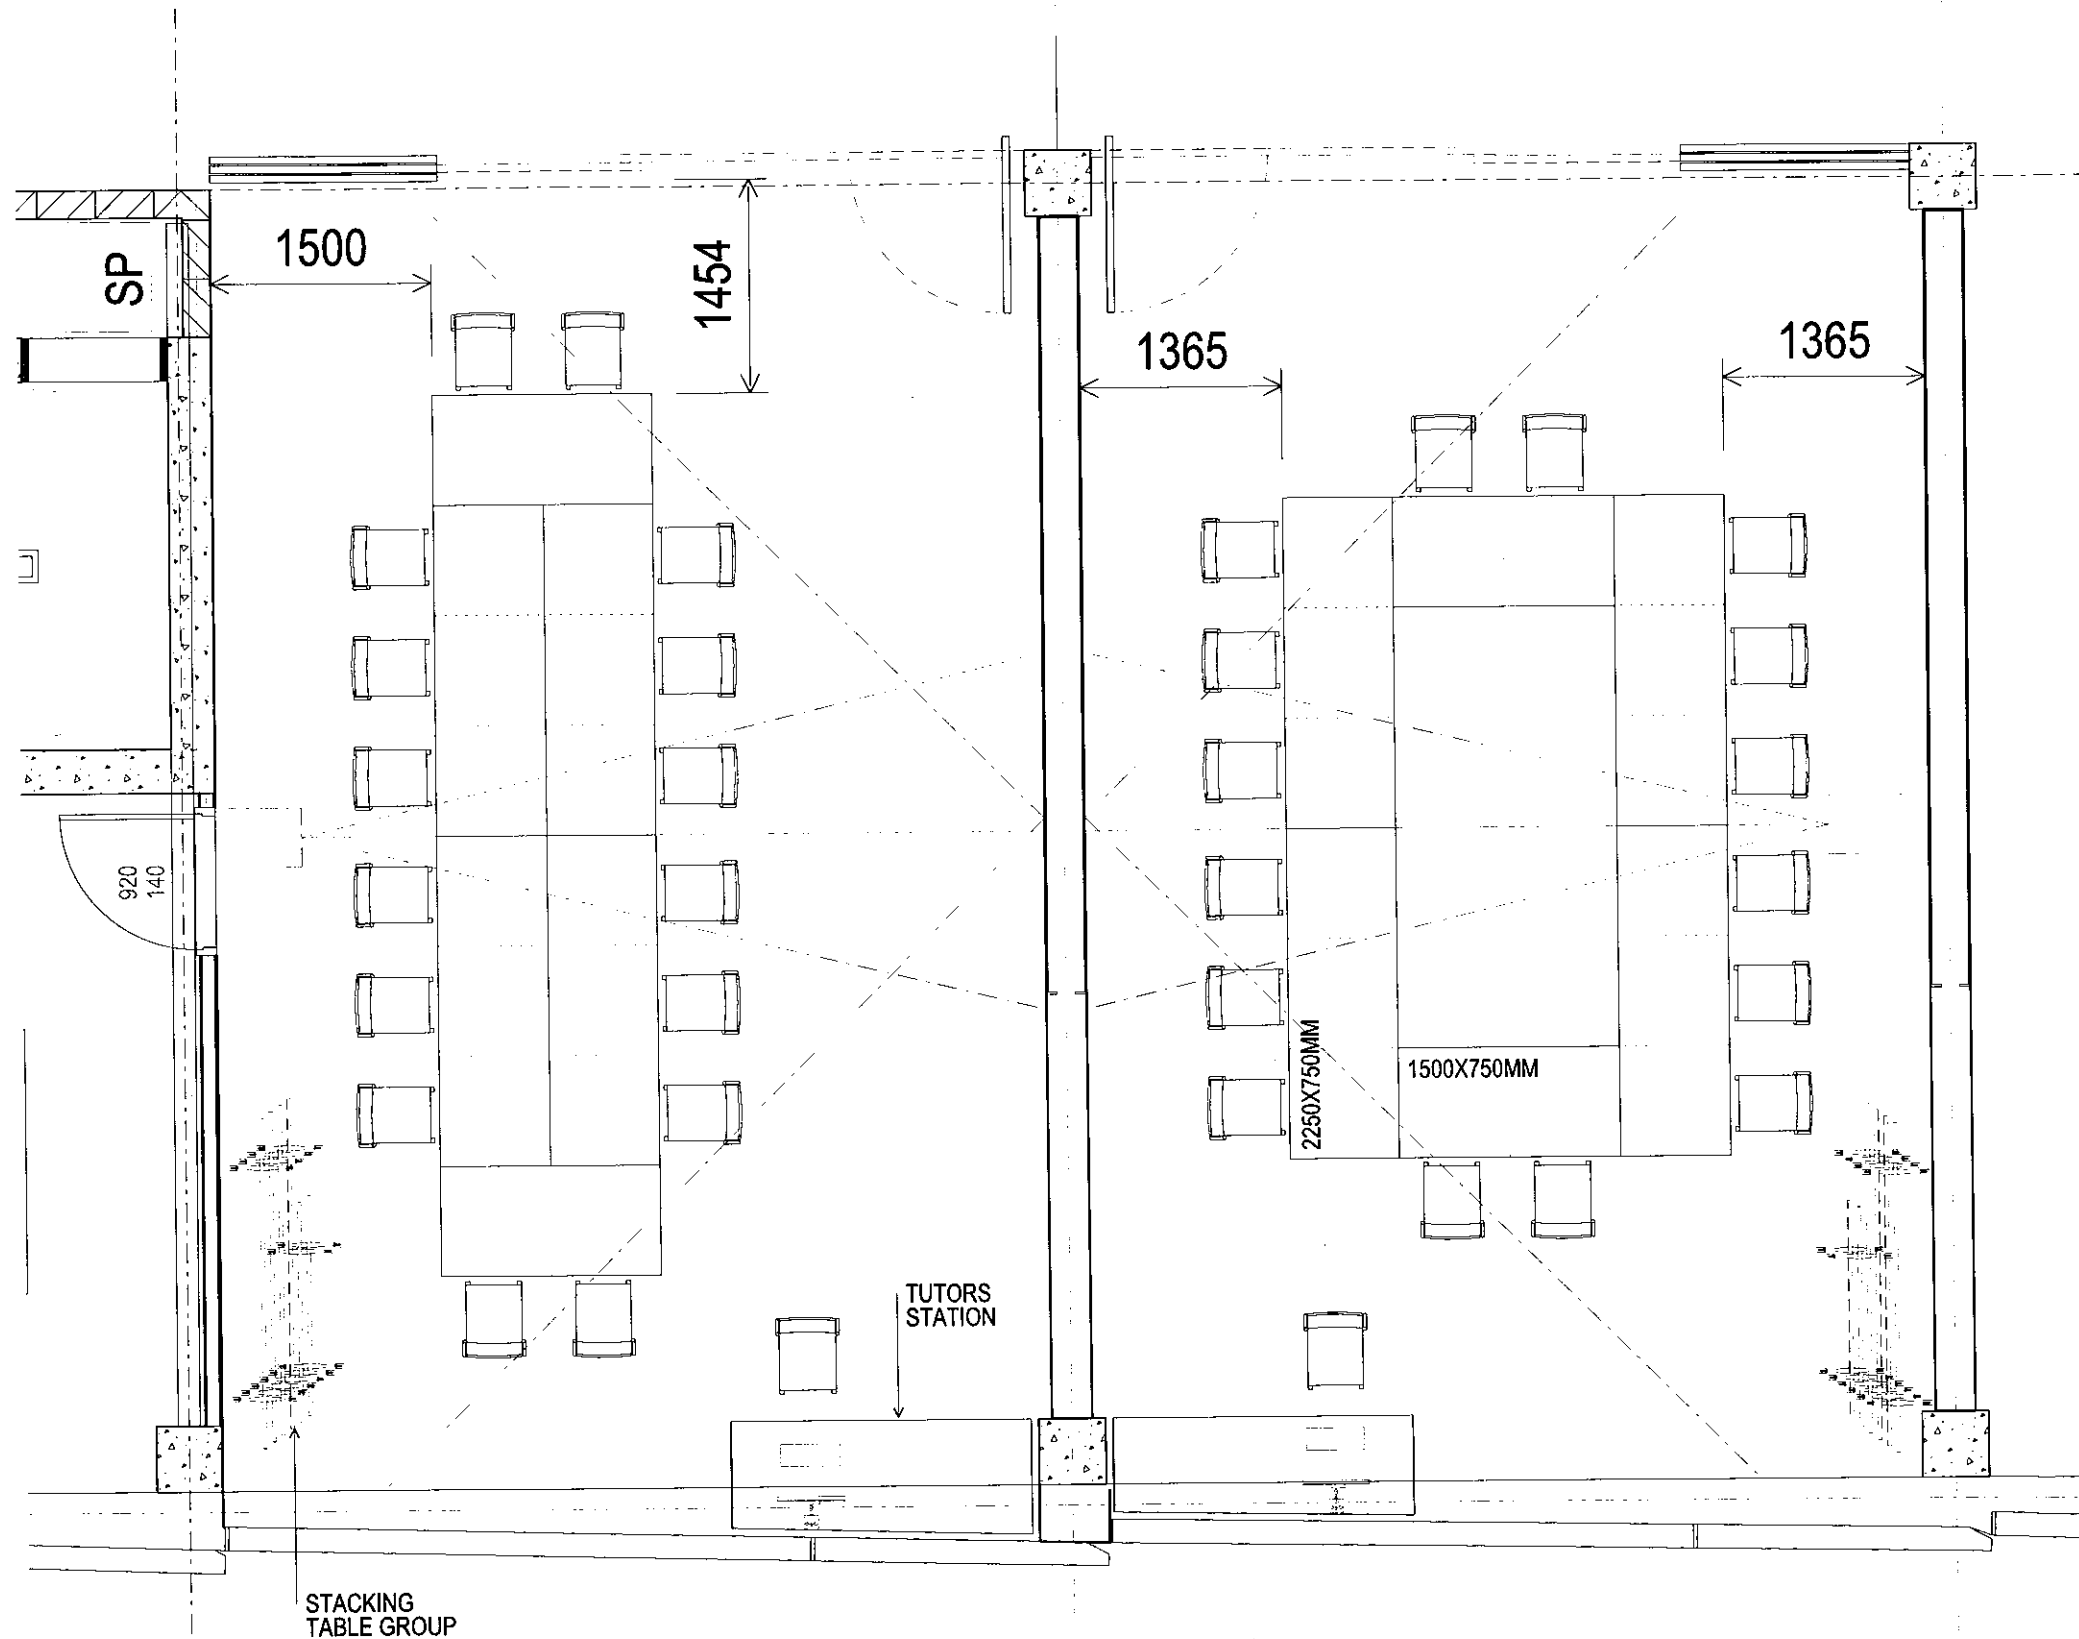


2250X750MM / 1500X750MM TABLES
FIXED WALL
CONFERENCE MODE

12

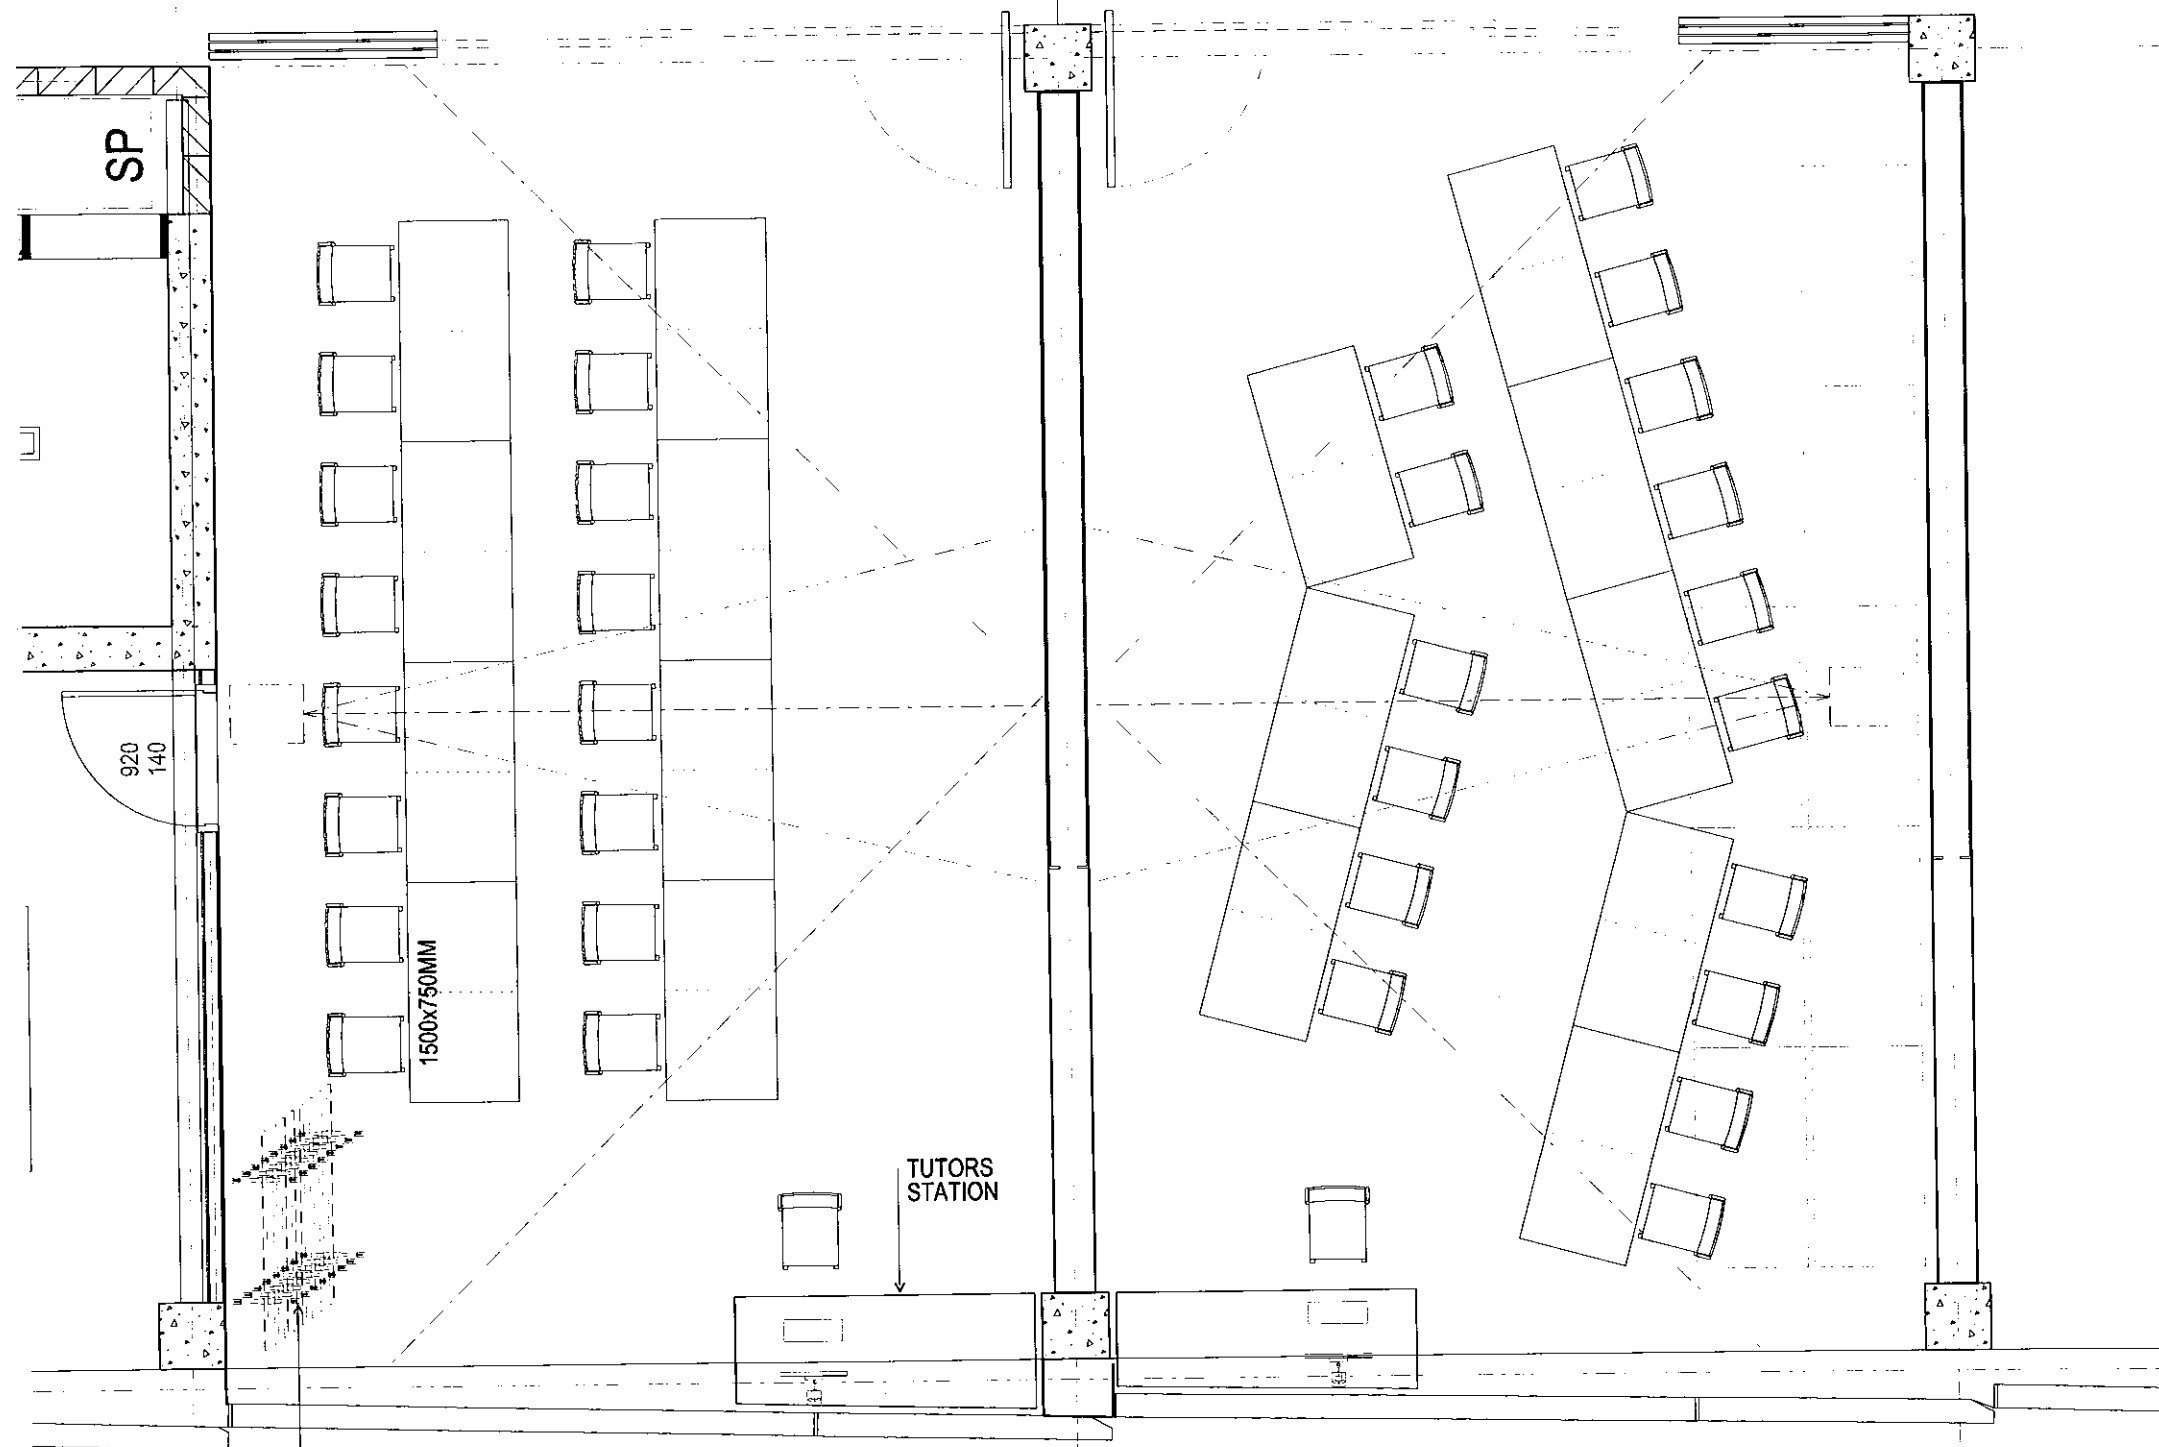

1500x750MM TABLES

13

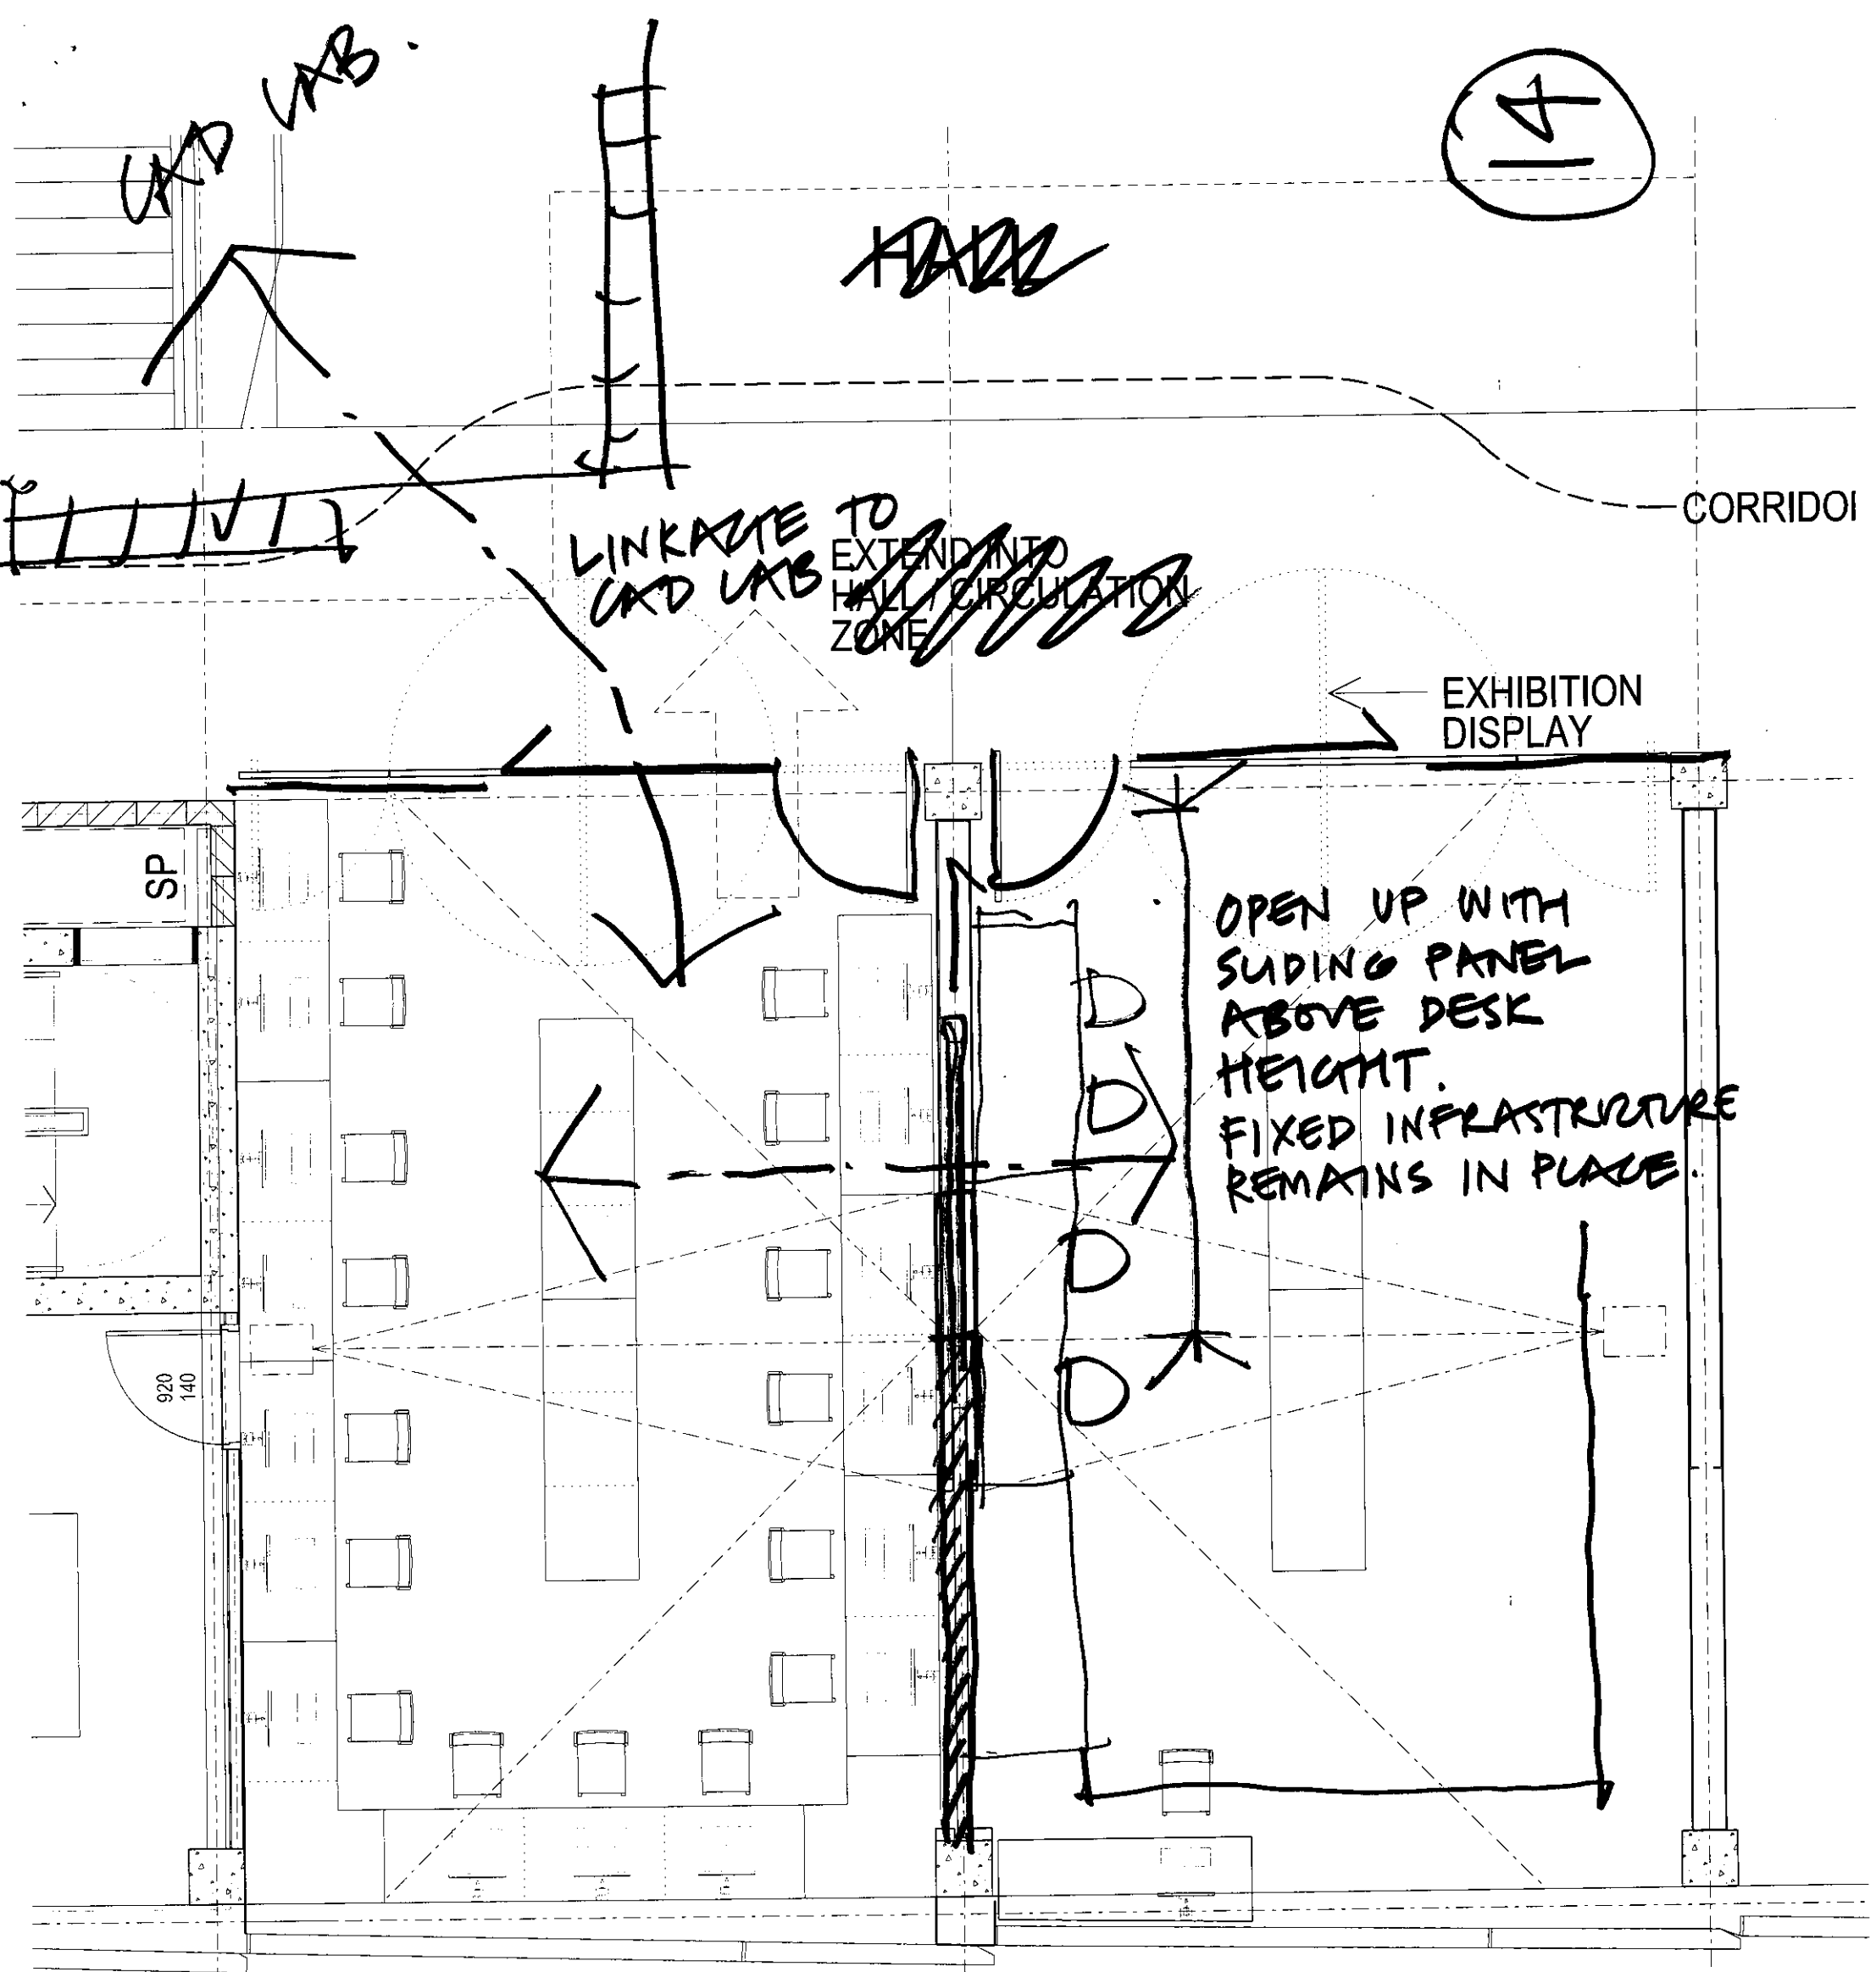

COMPUTER LAB

1500X750MM TABLES
2250X750MM TABLES