

JWA MARK-UP
14 OCT 2011
STUDIO STRATEGY

'QUIET' STUDIO

'CAD ENABLED' STUDIOS
> PERIMETER SEATING
> FIXED PC'S X 16
> SLIDER (CHECK SEAT NUMBERS)

'QUIET' STUDIOS

CONNECTION?


HALL STUDIO
> INFORMAL STUDY
> NON-BOOKABLE

'ACTIVE' STUDIO (CATALYST)

TERRACE STUDIO

'QUIET' STUDIO

'ACTIVE' STUDIOS
> EXHIBITION MODE (ALL OPEN)
> BREAKOUT MODE (SLIDERS CLOSED, HALL EDGE OPEN)
> SEMINAR MODE (ALL CLOSED)
> PAIRED MODE (2 SLIDERS OPEN)

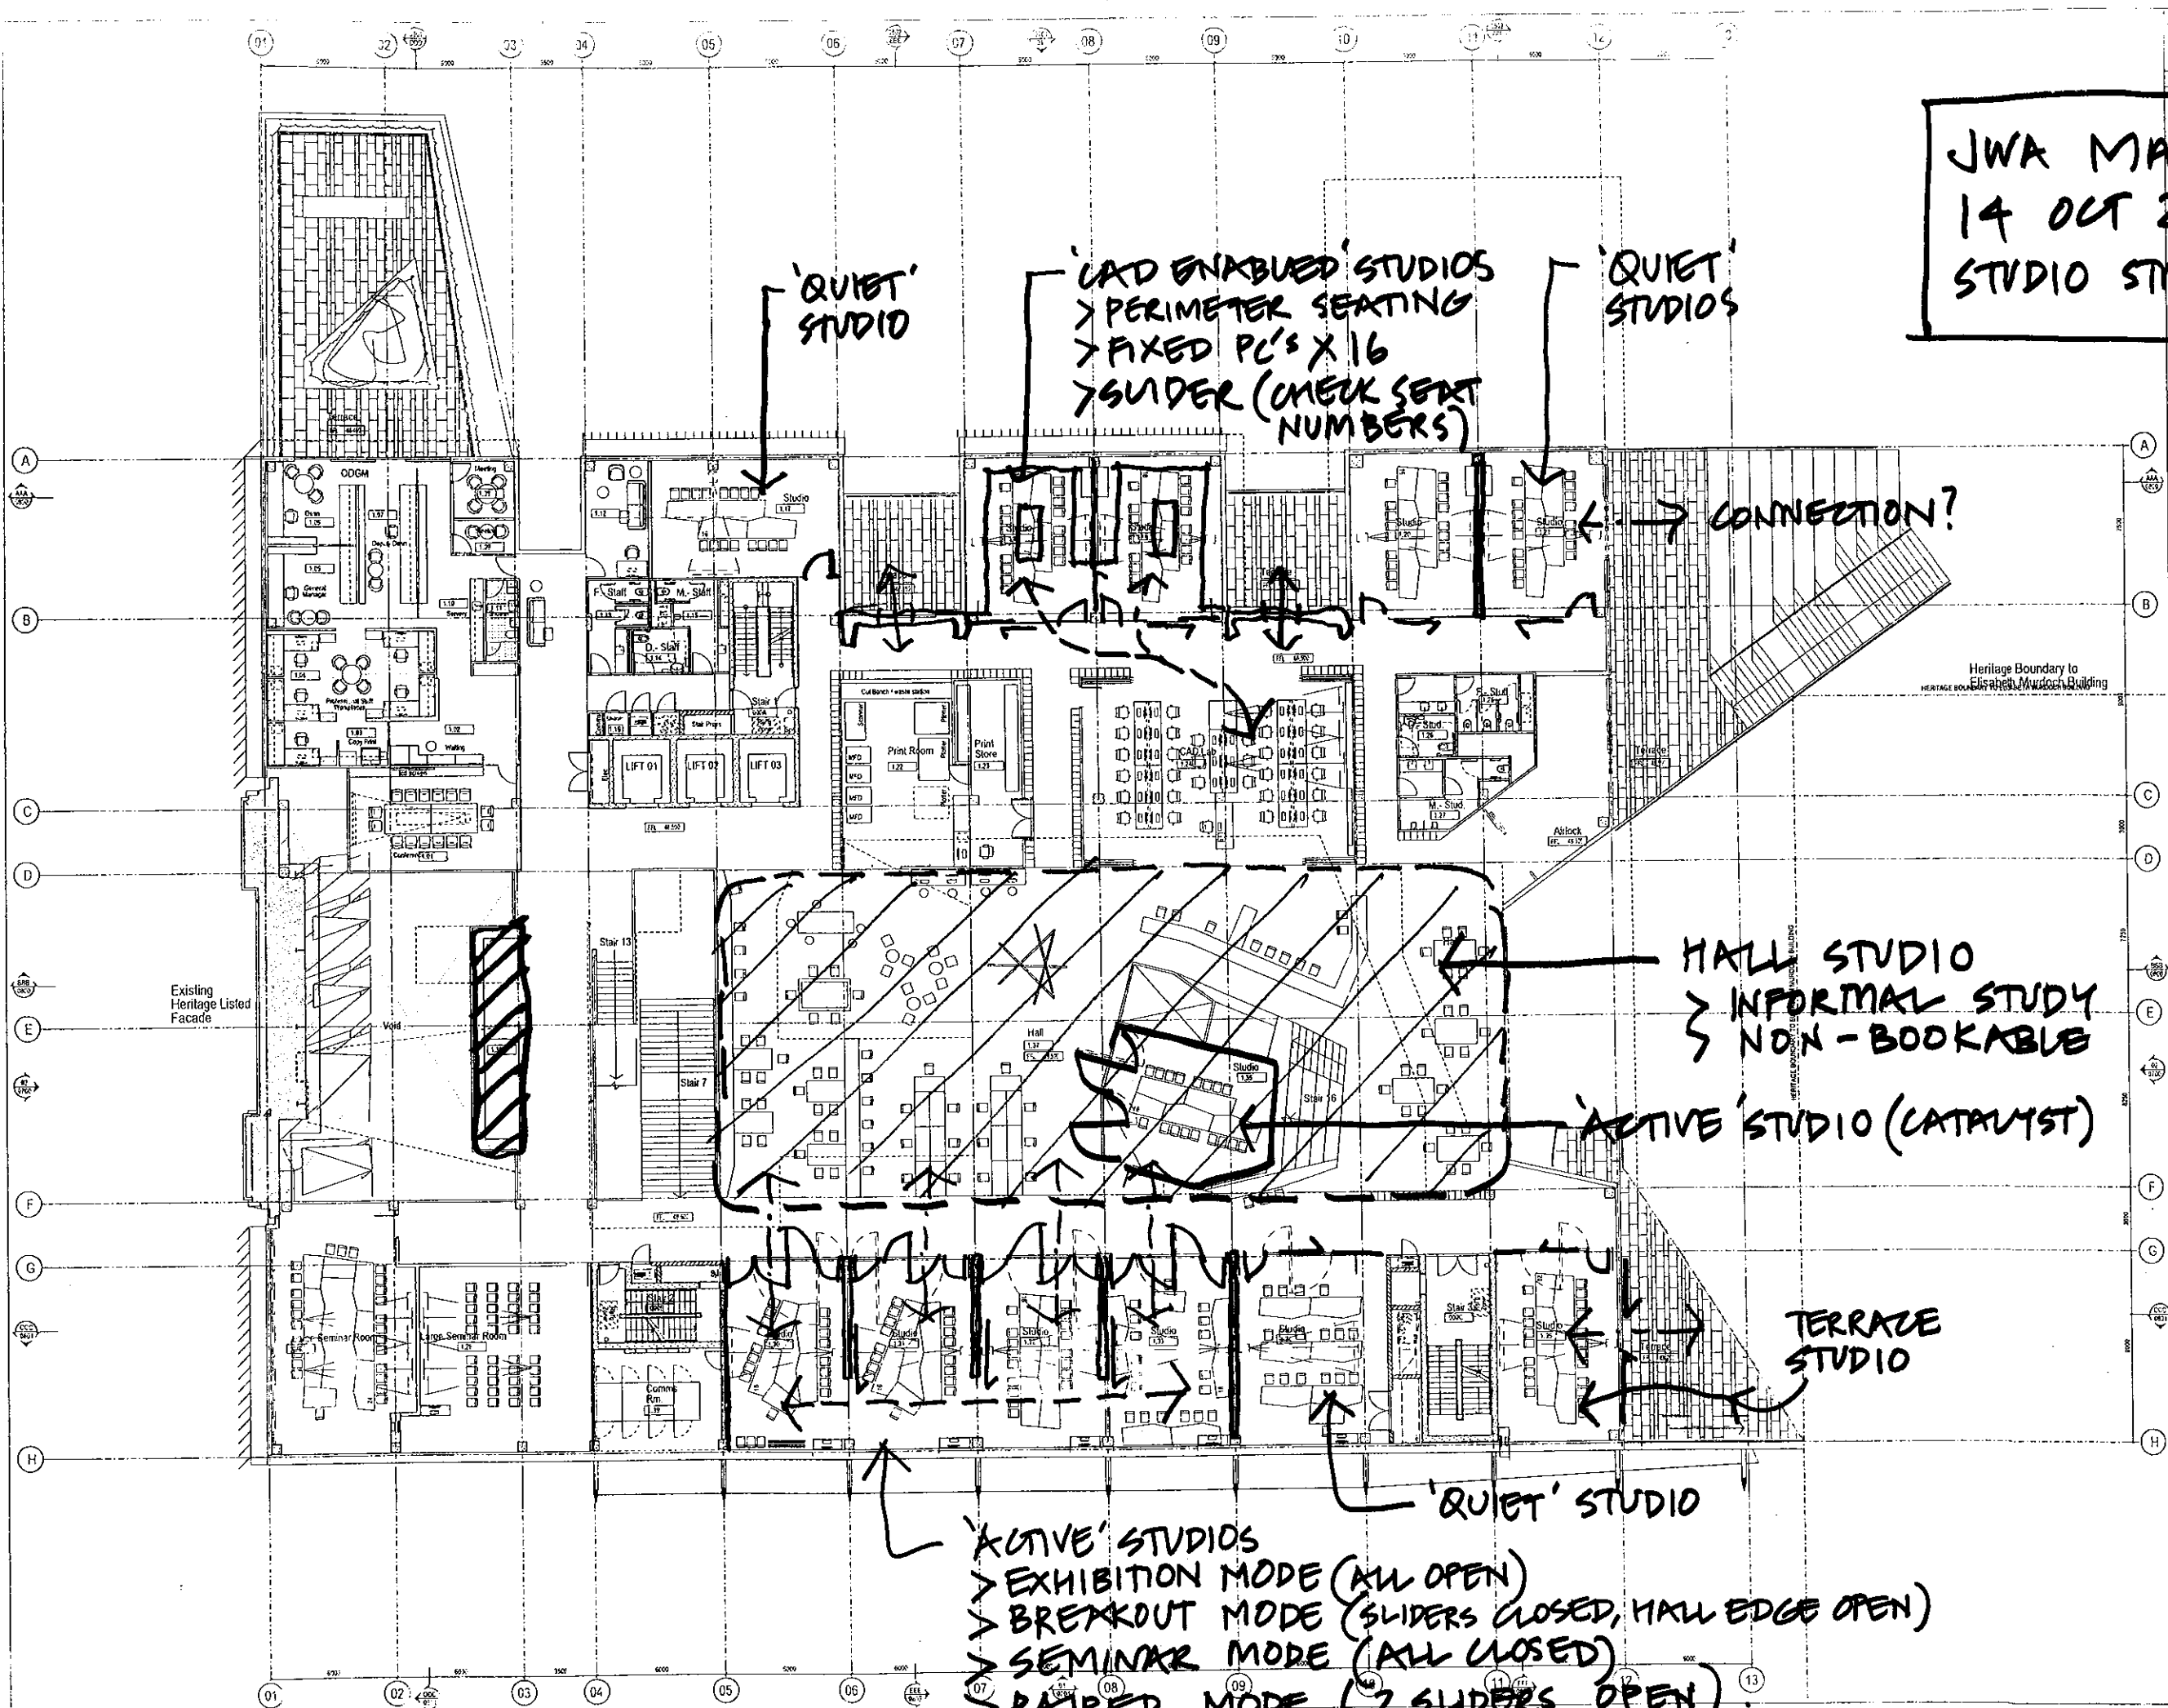

Heritage Boundary to Elisabeth Murdoch Building

01	02	03	04	05	06	07	08	09	10	11	12	13
A	B	C	D	E	F	G	H					

NADAAA

John Wardle Architects

© 2011 John Wardle Architects
Level 10, 180 Russell Street, Melbourne Victoria 3000 Australia
Tel: +613 9654 8100 www.johnwardlearchitects.com

Client: University of Melbourne
Parkville Campus

Project: Faculty of Architecture
Building and Planning

Title: GENERAL ARRANGEMENT
LEVEL 01 FLOOR PLAN - LO

Project No.	0915	1:100 @ A0
Drawing No.	AR1002	1:200 @ A0
Drawn	AR	01

PRELIMINARY ISSUE

JWK MARK-UP
14 OCT 2011
STUDIO STRATEGY

WORK IN PROGRESS

'LARGE' STUDIO

'QUIET' STUDIOS
> SEMINAR MODE
> PAIRED MODE
(OPERABLE WALL)

DOORS?
SUSPENDED STUDIO
(CATALYST)

'QUIET' STUDIOS

HATCHED AREAS
NEED TO BE
FOR SMALL
GROUPS OF
STUDENTS,
SKY 3 TO 6,
TO DO COLLABORATIVE
WORK. FINAL
LOCATIONS TBC.

'CAD ENABLED' STUDIO
7 FIXED PC'S X 16
> SLIDER (CHECK SEAT NUMBERS)

'QUIET' STUDIOS.
> NO SLIDERS BETWEEN

General Notes

Heritage Boundary to Elisabeth Murdoch Building

HERITAGE BOUNDARY TO ELISABETH MURDOCH BUILDING

REVISIONS

NO	DATE	DESCRIPTION	BY	CHKD
01	02/10/11	PRELIMINARY ISS		

NADAAA
 NADAAA
 1200 Riverside Drive
 Suite 102
 Melbourne, VIC 3000
 Australia
 Tel: +61 3 9554 8700
 Email: nadaaa@nadaaa.com

John Wardle Architects
 © 2011 John Wardle Architects
 Level 10, 180 Russell Street, Melbourne, Victoria 3000 Australia
 Tel: +61 3 9554 8700
 www.johnwardle.com.au


Client: University of Melbourne
 Parkville Campus
 Project: Faculty of Architecture
 Building and Planning
 The: GENERAL ARRANGEMENT
 LEVEL 02 FLOOR PLAN - LUZ

Project No: 0913
 Drawing No: AR1003
 Date: May 2011
 Scale: 1:50 @ A2
 1:200 @ A3
 Revision: 01

PRELIMINARY ISSUE

2

JWA MARK-UP
14 OCT 2011
STUDIO STRATEGY

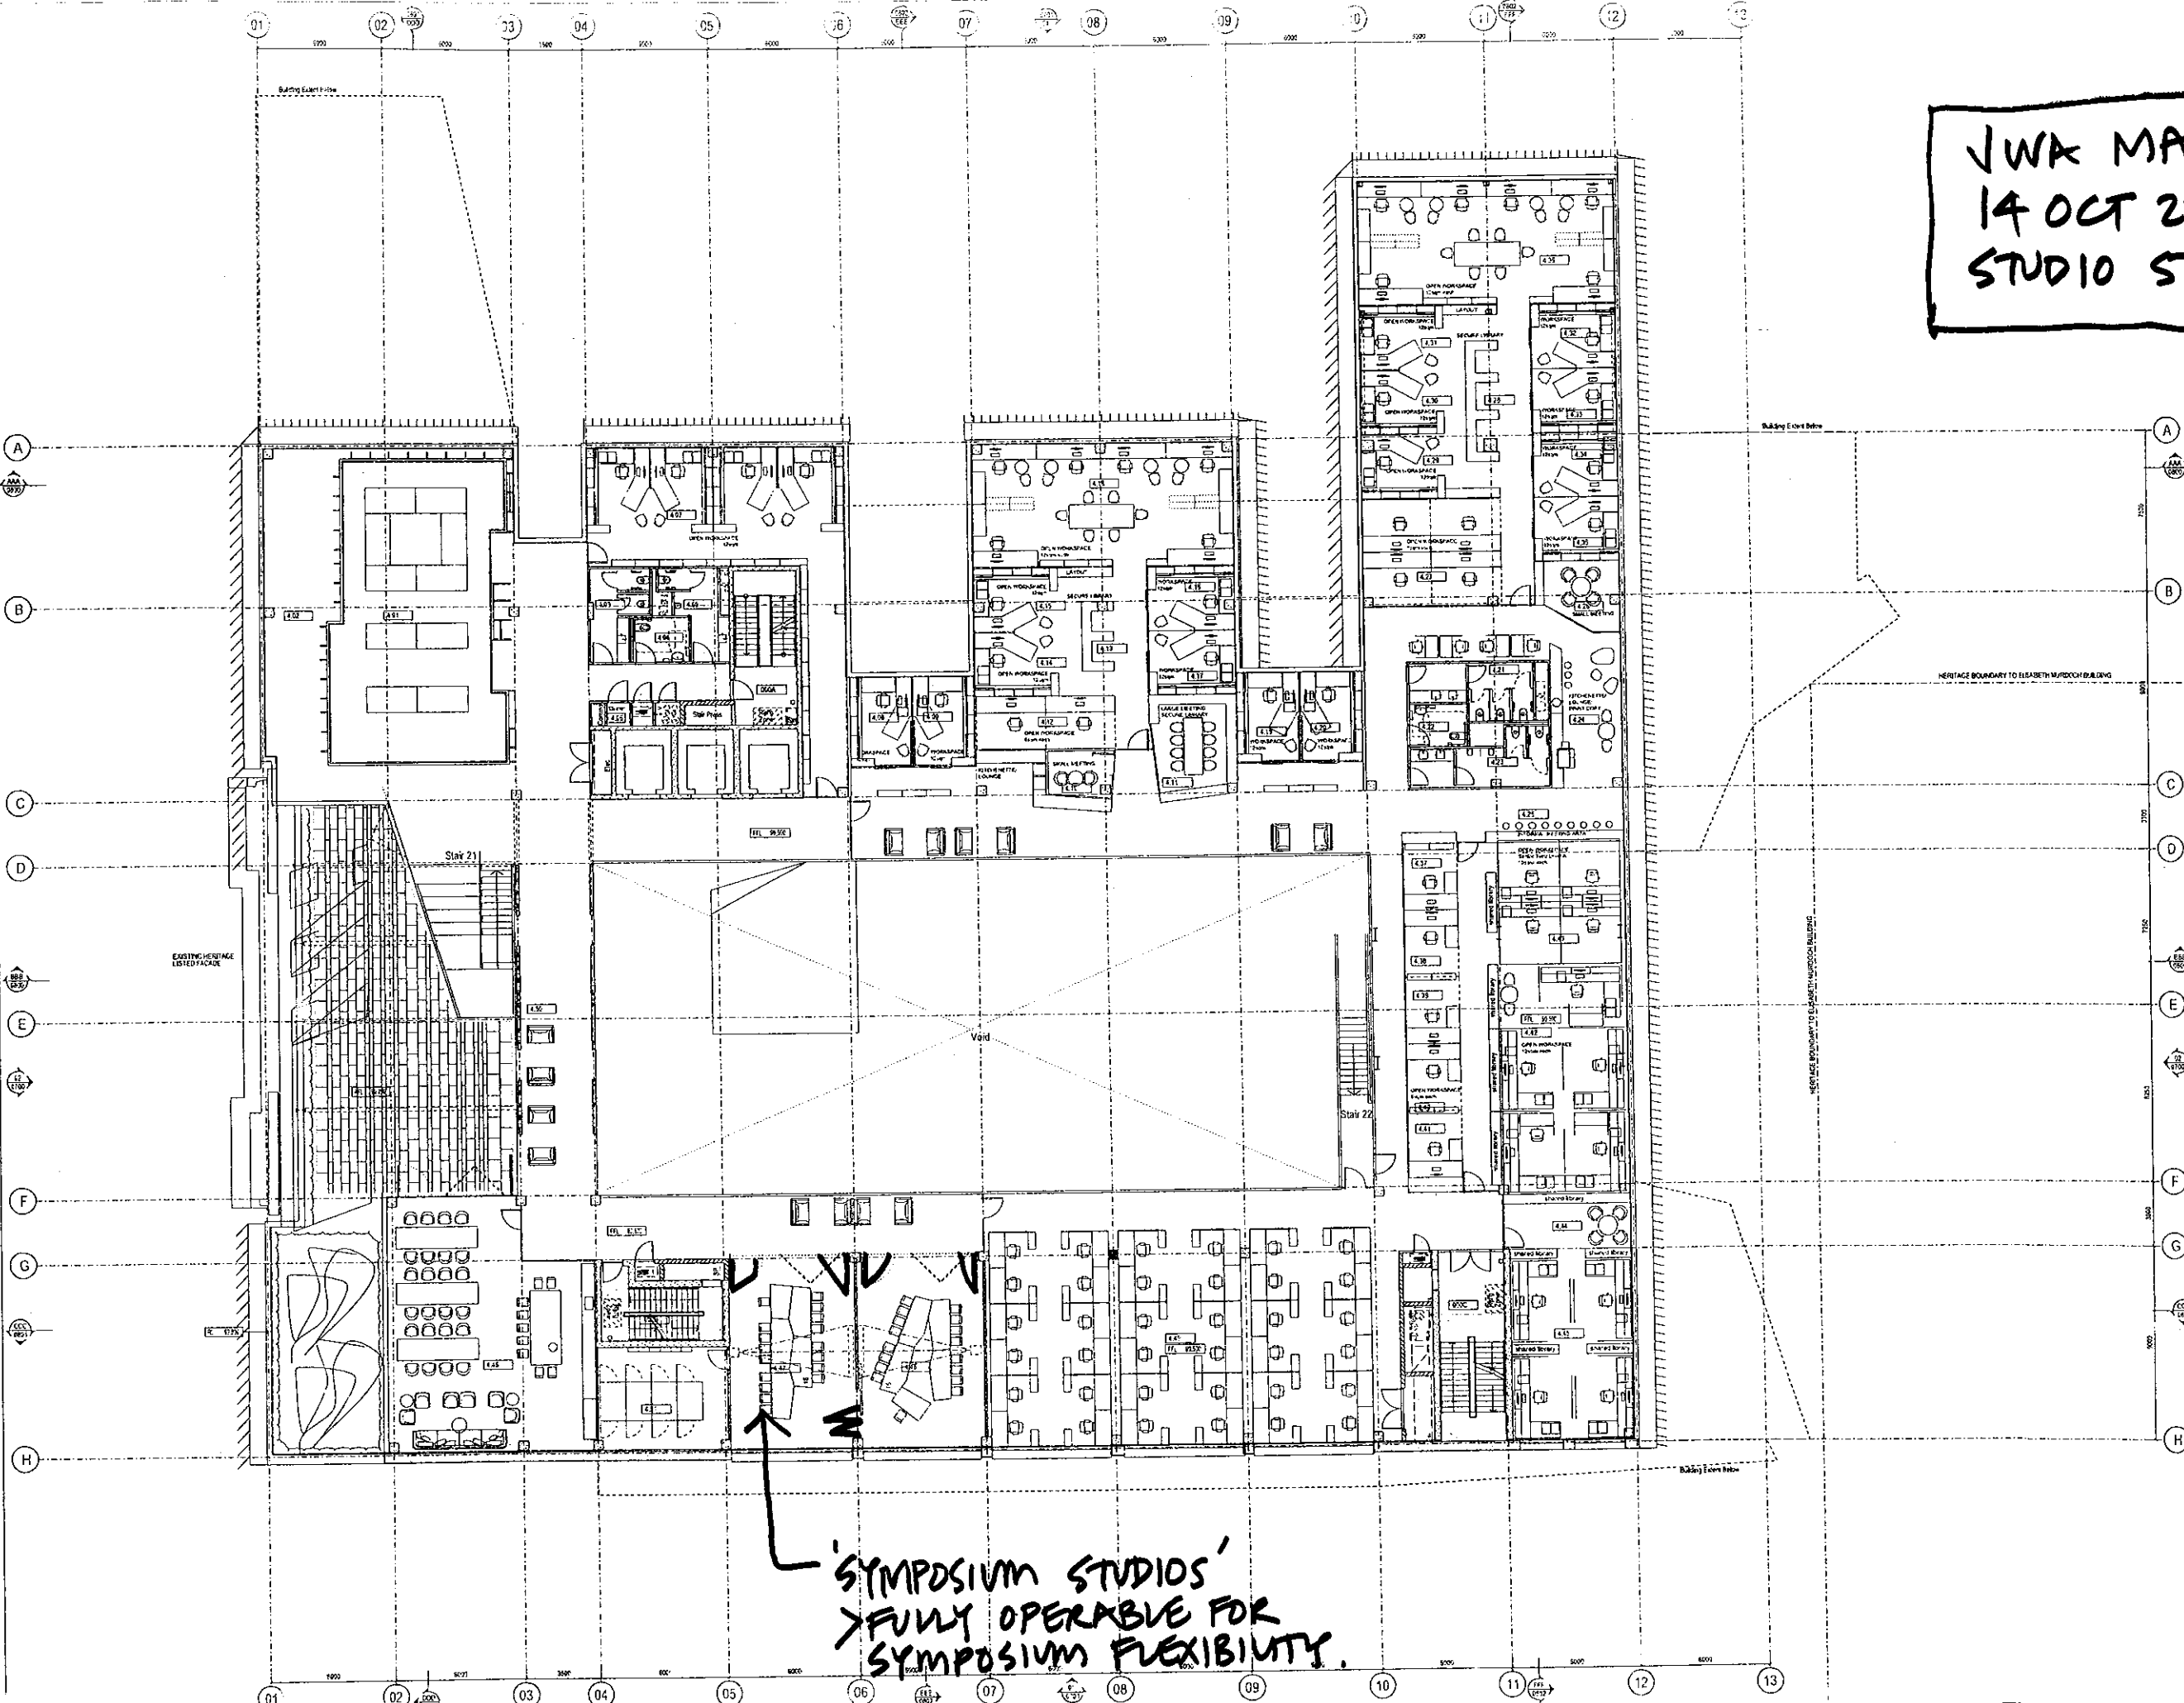

GENERAL NOTE
THIS DRAWING IS A PRELIMINARY ISSUE. IT IS NOT TO BE USED FOR CONSTRUCTION. ANY CHANGES TO THE DESIGN SHALL BE MADE BY A REVISION TO THIS DRAWING. THE DESIGNER ACCEPTS NO LIABILITY FOR ANY DAMAGE OR LOSS ARISING FROM THE USE OF THIS DRAWING.

Rev	Issue	Description	Date
01	01	PRELIMINARY ISSUE	07/10/11

NADAAA
NADAAA
100, Franklin
Street No. 2
Boronia
Melbourne
3101 VIC
Australia
Tel: +61 3 9544 0100
Fax: +61 3 9544 0101
Email: nadaaa@nadaaa.com.au

John Wardle Architects
© 2011 John Wardle Architects
Level 10, 180 Russell Street, Melbourne Victoria
Tel: +61 3 9544 0100
www.johnwardle.com.au

Client: University of Melbourne
Parkville Campus

Project: Faculty of Architecture
Building and Planning

General Arrangement
LEVEL 4 FLOOR PLAN - L04

Project No.	0913	Scale	1:500 @ A4
Drawing No.	AR1005	Revision	01
Date	2011	Drawn	Co-Ord
Filename	P:\0909\0913\1005\Architecture Building\Production\CAD\Drawings\Level 4 L04.rvt		

PRELIMINARY ISSUE

4

HALL

CORRIDOR →

EXTEND INTO
HALL / CIRCULATION
ZONE

ACCESS
CONTROL
DOOR

EXHIBITION
DISPLAY
(PIN-UP)

← WRITABLE
GLASS
SURFACE

PIN UP
SURFACE →

CONVERSATIVE
LEARNING
LAYOUT
(GROUPS OF
4-6)

PIN UP
SURFACE
ON DOOR
BOTH
SIDES.

TUTOR'S
STATION

UNIVERSITY STANDARD
WHITE PAINTED
PROJECTION SURFACE
(2.4M WIDTH IMAGE)
OR SPECIAL PIN UP
PROJECTION SURFACE

- BAG ALLOWS
- MODEL SETDOWN
- AV & PC STATION.

ACTIVE STUDIO - BREAKOUT

1500X750MM TABLES
2250X750MM TABLES

5

HALL

EXTEND INTO
HALL / CIRCULATION
ZONE

EXHIBITION
DISPLAY

CORRIDOR

SP


920
140

TUTOR'S
STATION

ACTIVE STUDIO - EXHIBITION

1500X750MM TABLES
2250X750MM TABLES

FOUR ABUSE &
STUCK ABUSE
TABLES.

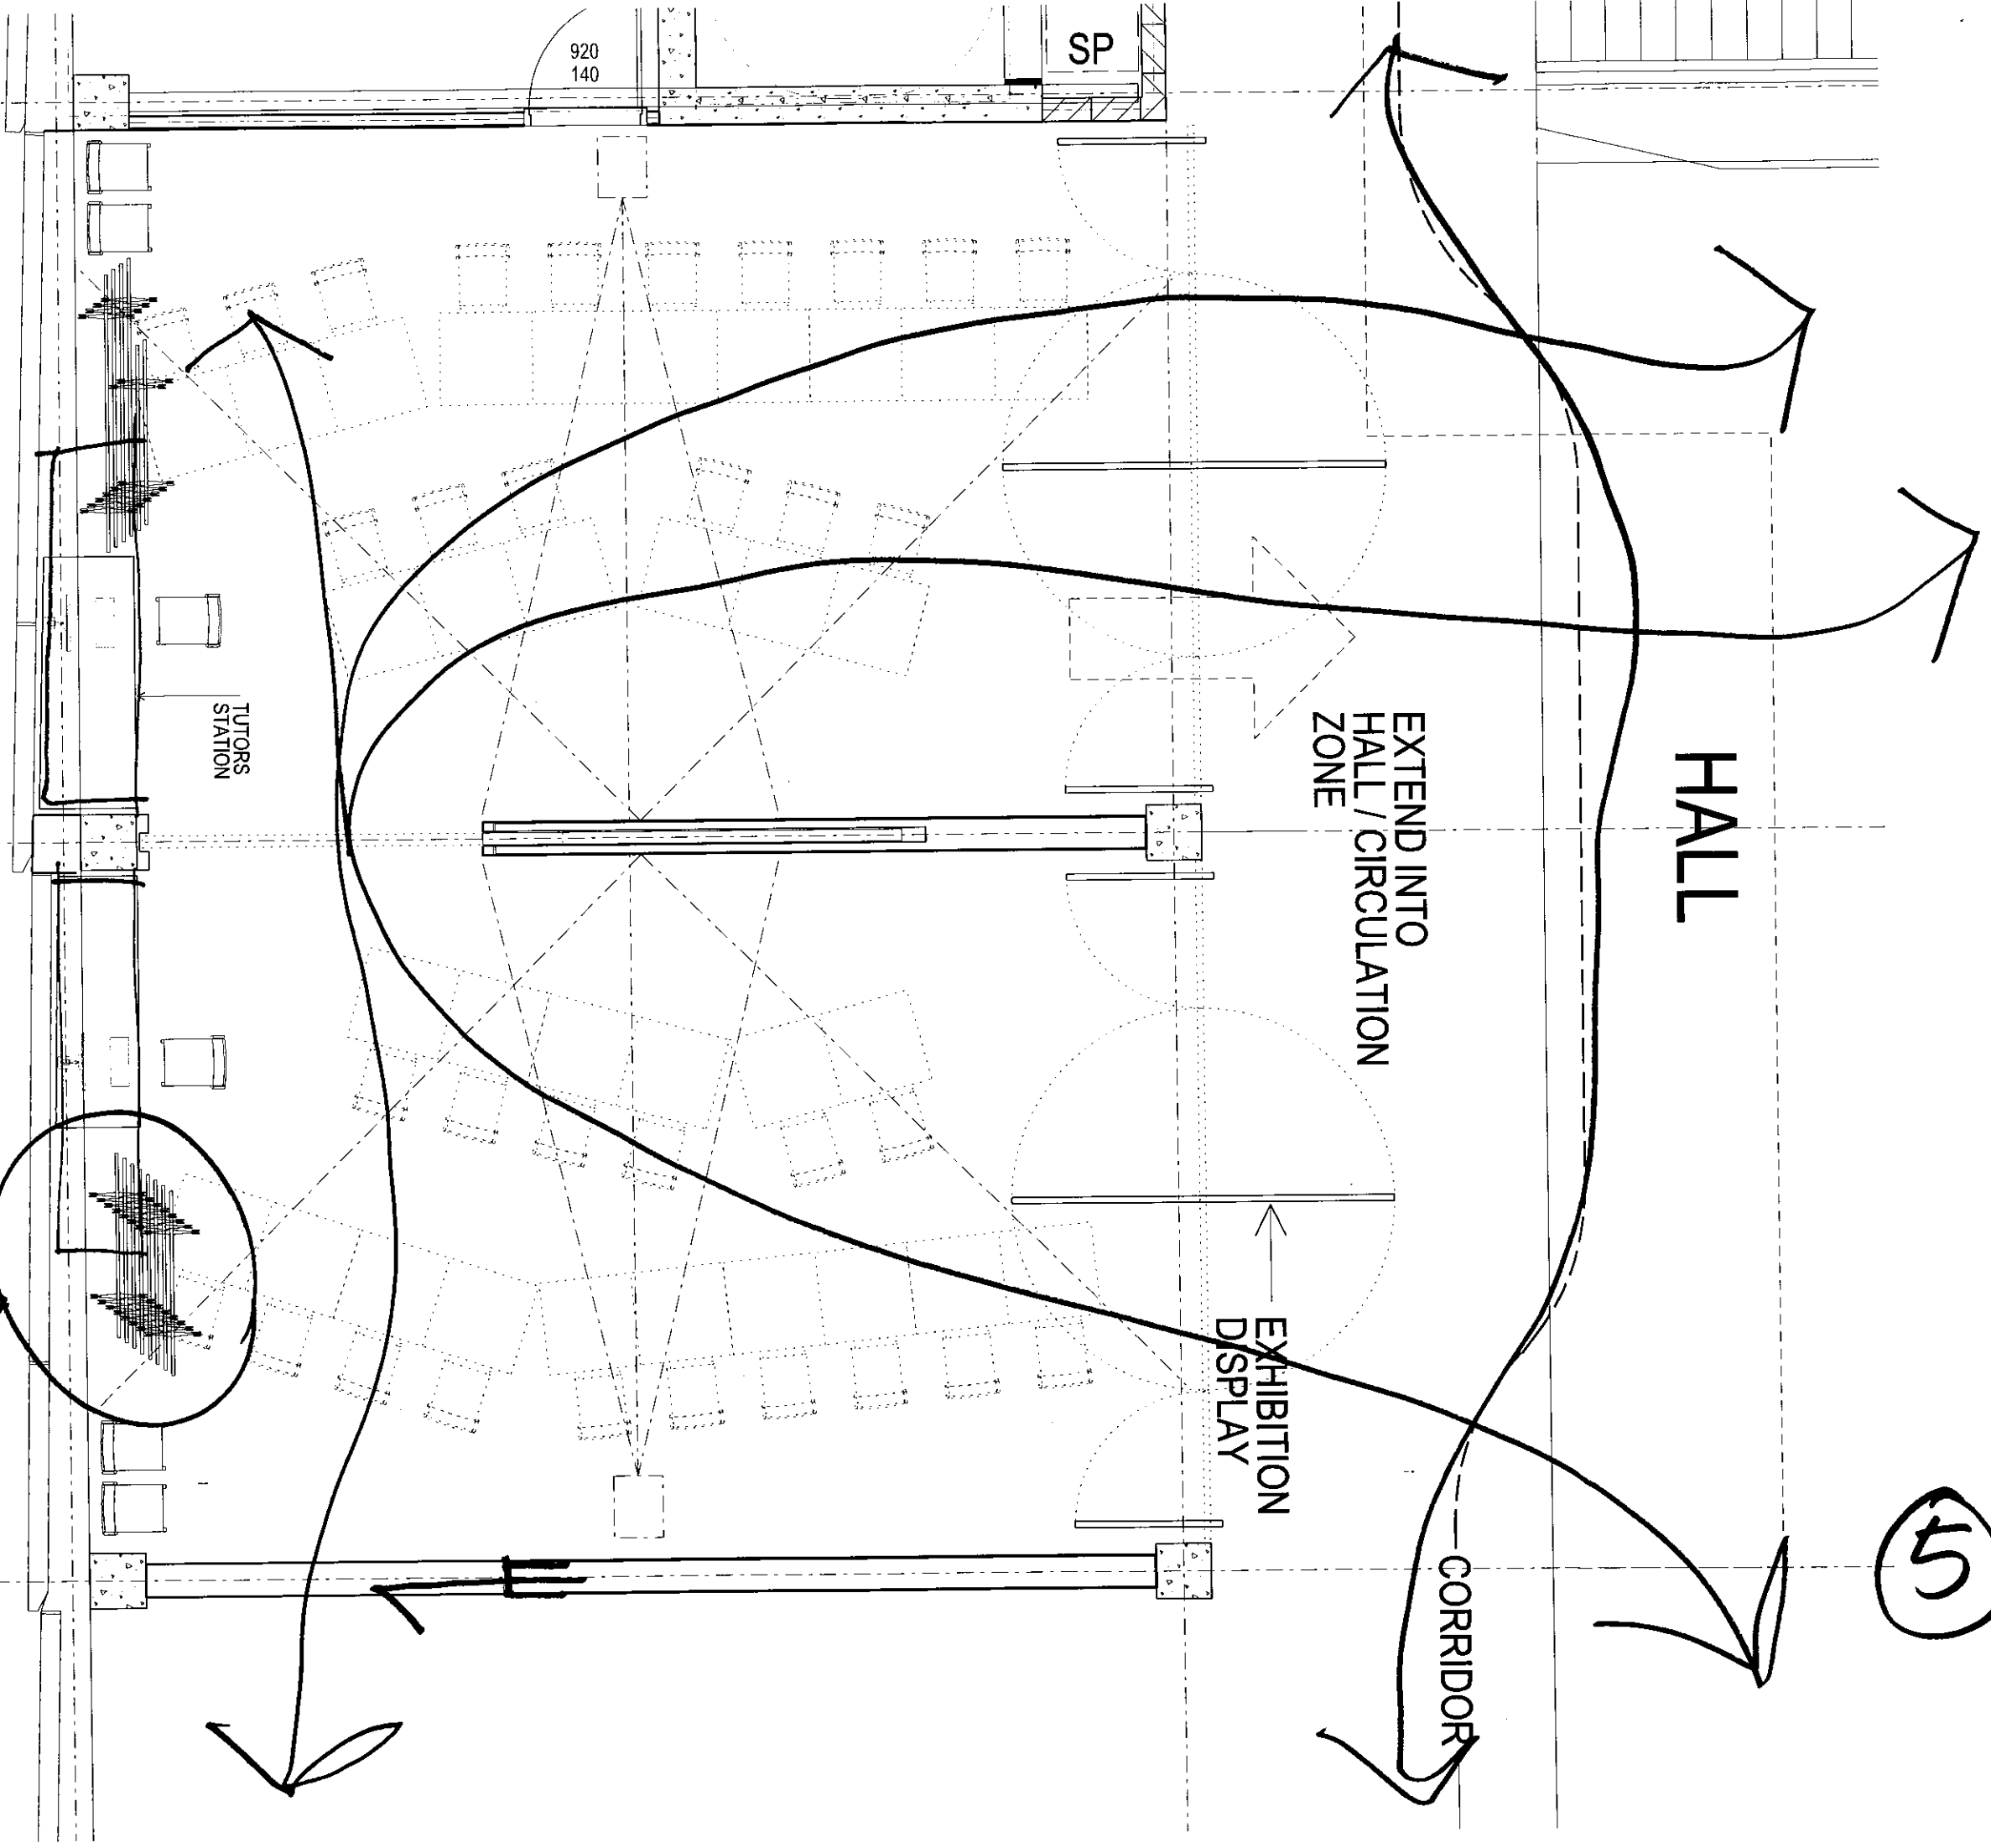

②

HALL

CORRIDOR

EXTEND INTO
HALL / CIRCULATION
ZONE

EXHIBITION
DISPLAY

SP

920
140


TUTOR'S
STATION

TRUBES TO
BE 900 HIGH.

GROUPWORK
ON 750 DEEP
TRUBES.

ACTIVE STUDIO - GROUPS

1500X750MM TABLES
2250X750MM TABLES

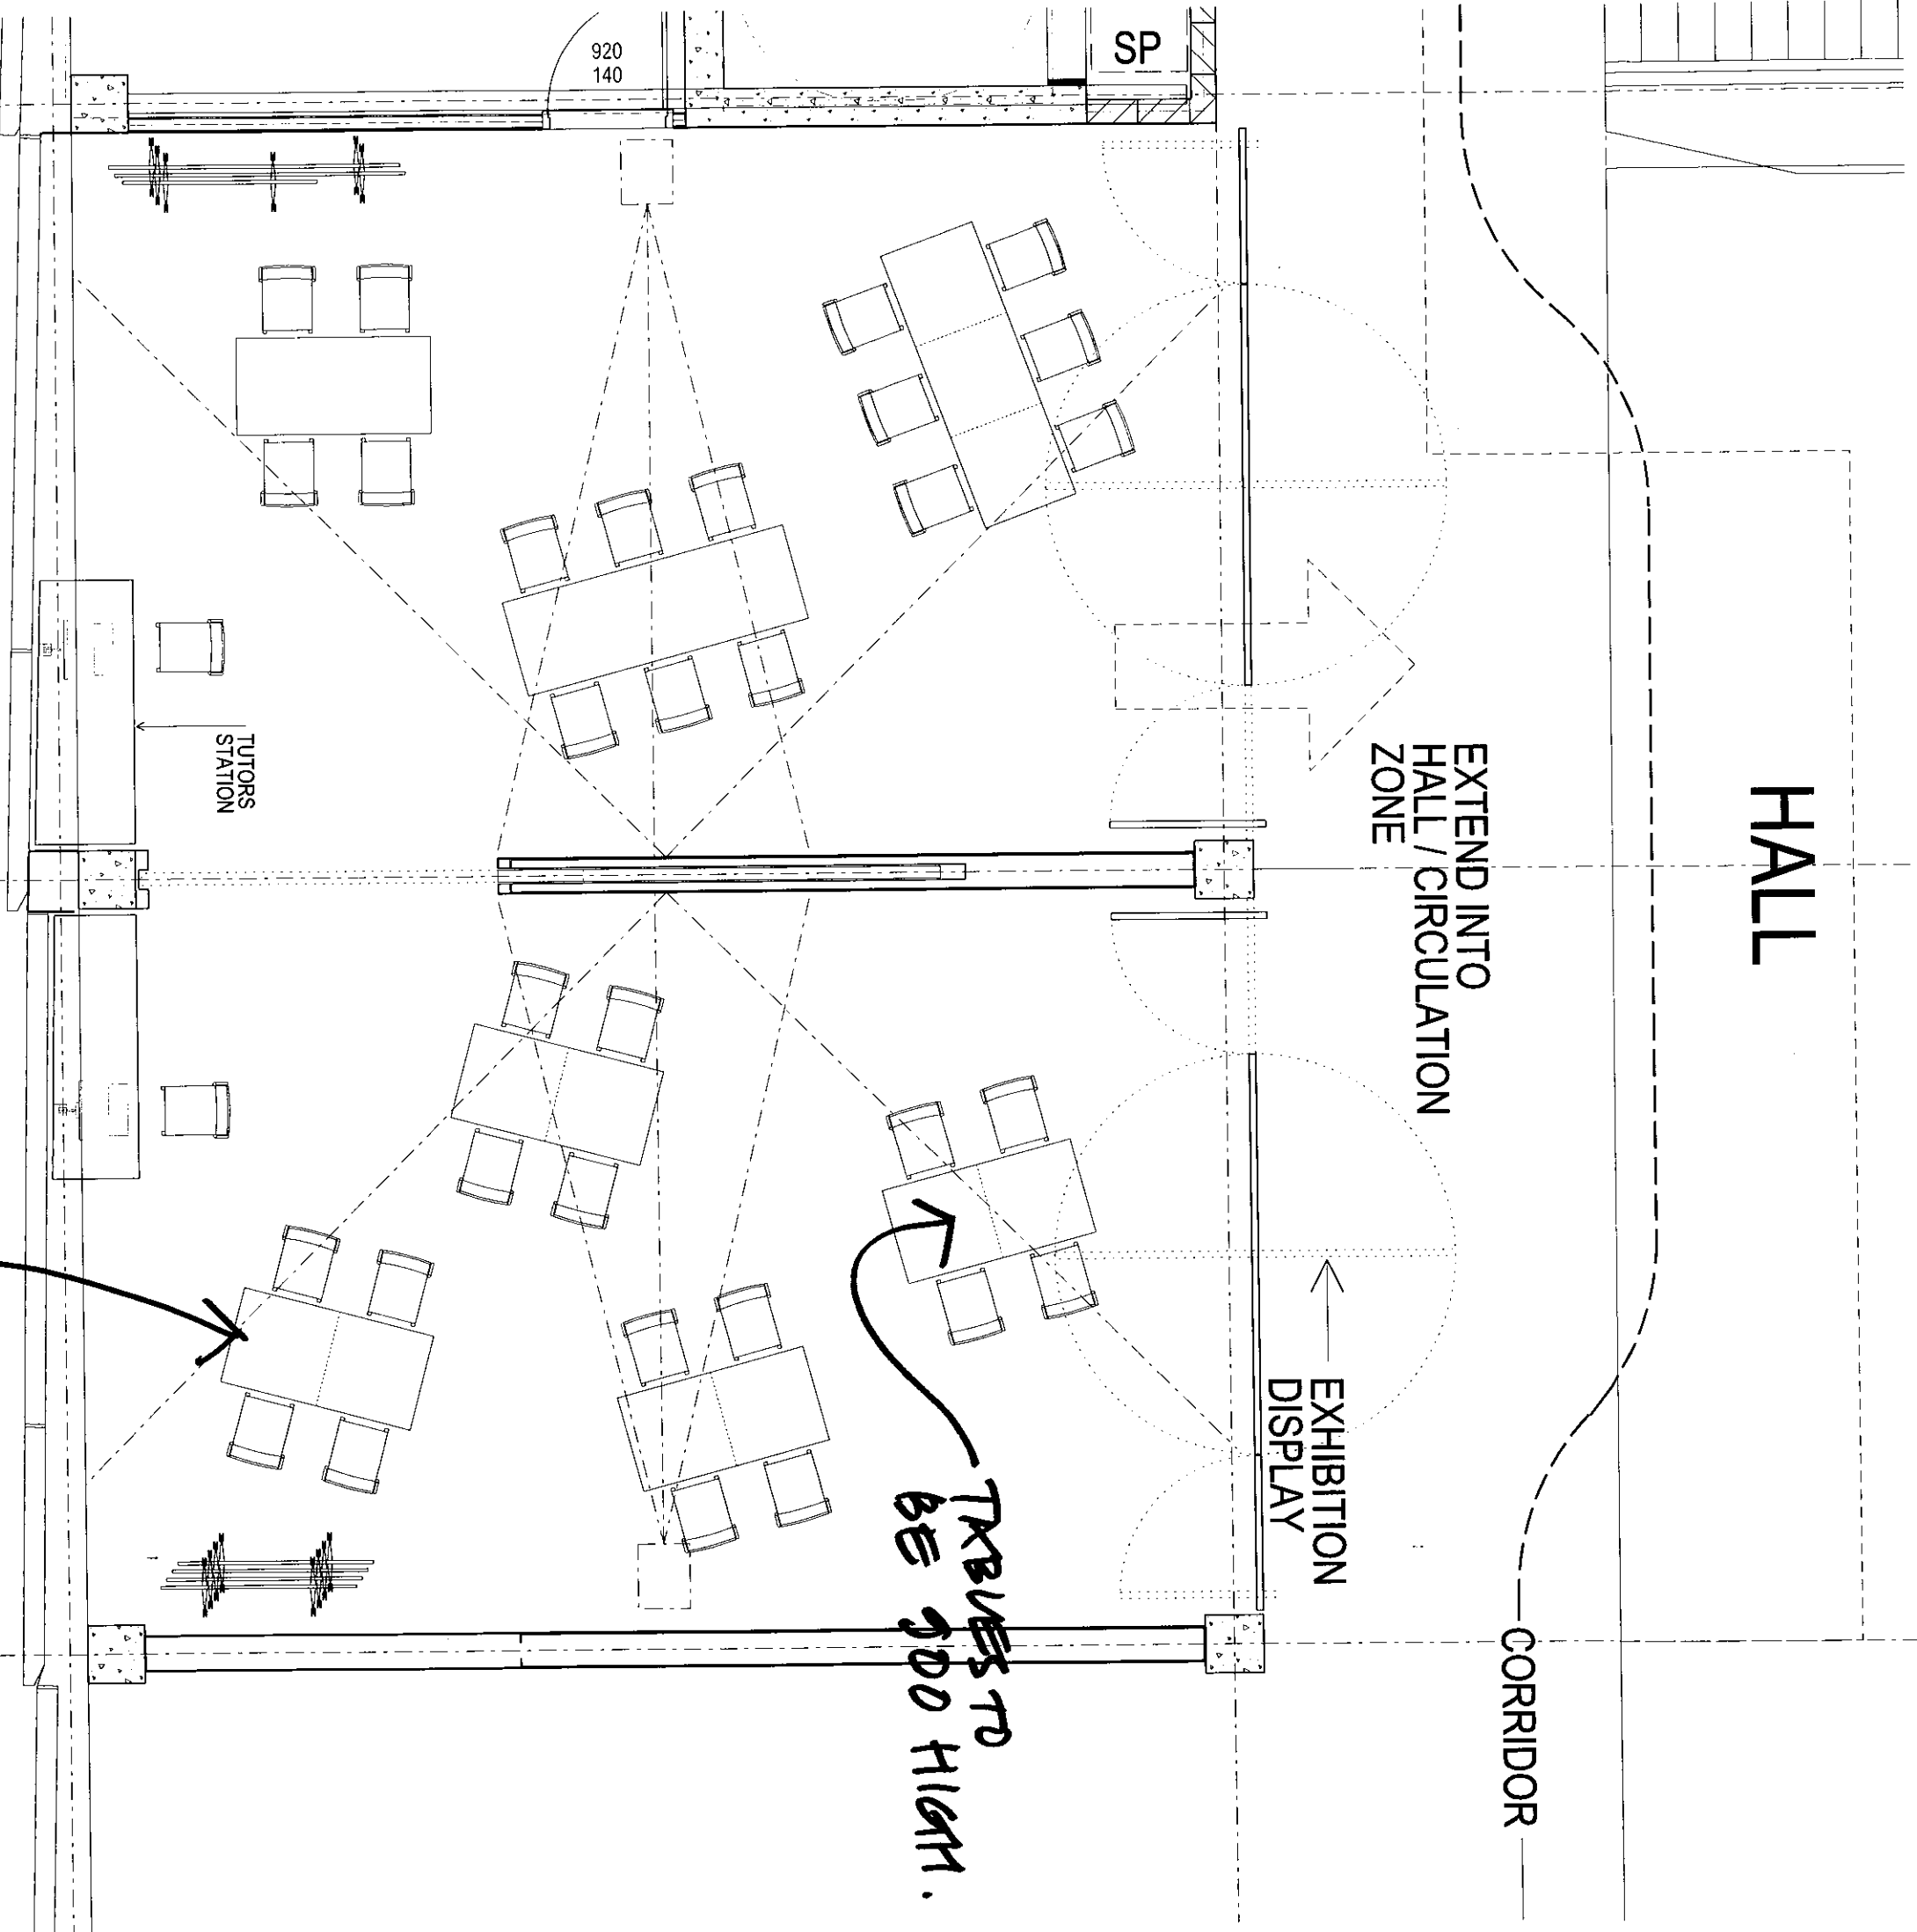

HALL

CORRIDOR

EXTEND INTO
HALL / CIRCULATION
ZONE

EXHIBITION
DISPLAY

SP

920
140


TUTOR'S
STATION

CLOSED,
IN SEMINAR
MODE.

CLOSED,
IN SEMINAR
MODE.

ACTIVE STUDIO - LAPTOP GROUPS
WITH SPACE
FOR LAPTOPS.

1500X750MM TABLES
2250X750MM TABLES

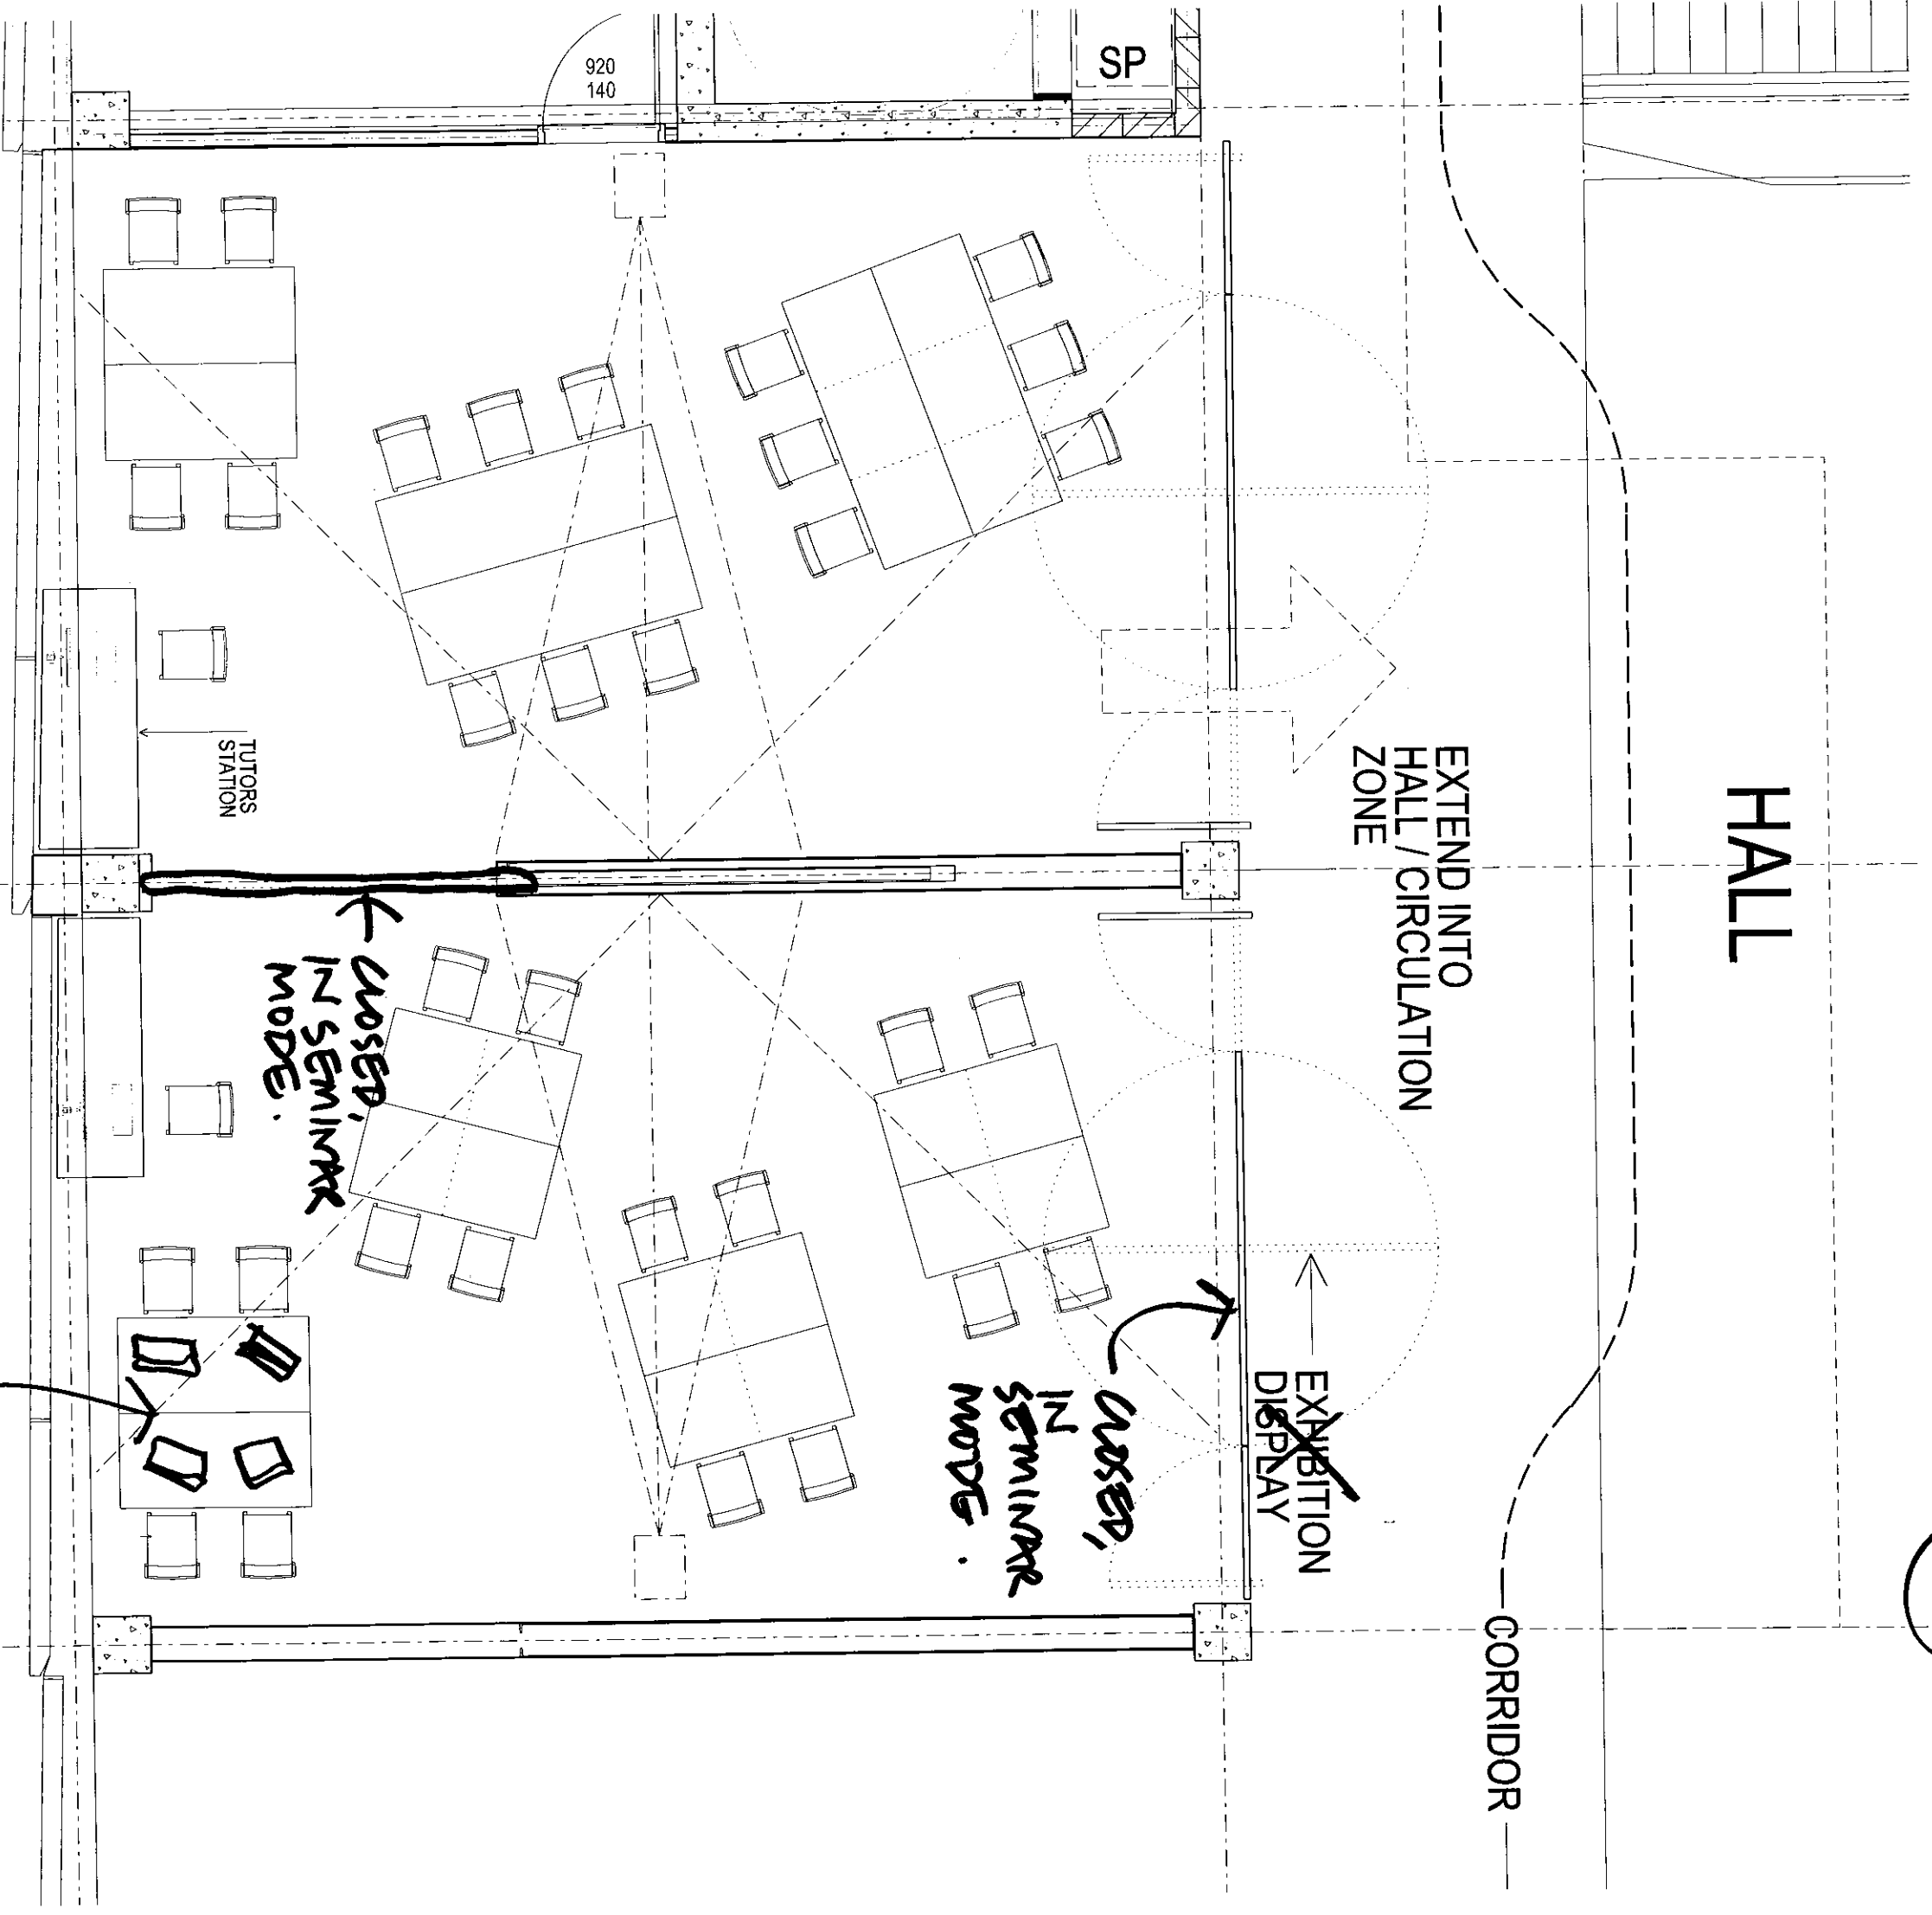

2

HALL

CORRIDOR

EXTEND INTO
HALL / CIRCULATION
ZONE

EXHIBITION
DISPLAY

SP

920
140


TUTORS
STATION


← used

← used

ACTIVE STUDIO - TUTORIAL


1500X750MM TABLES
2250X750MM TABLES

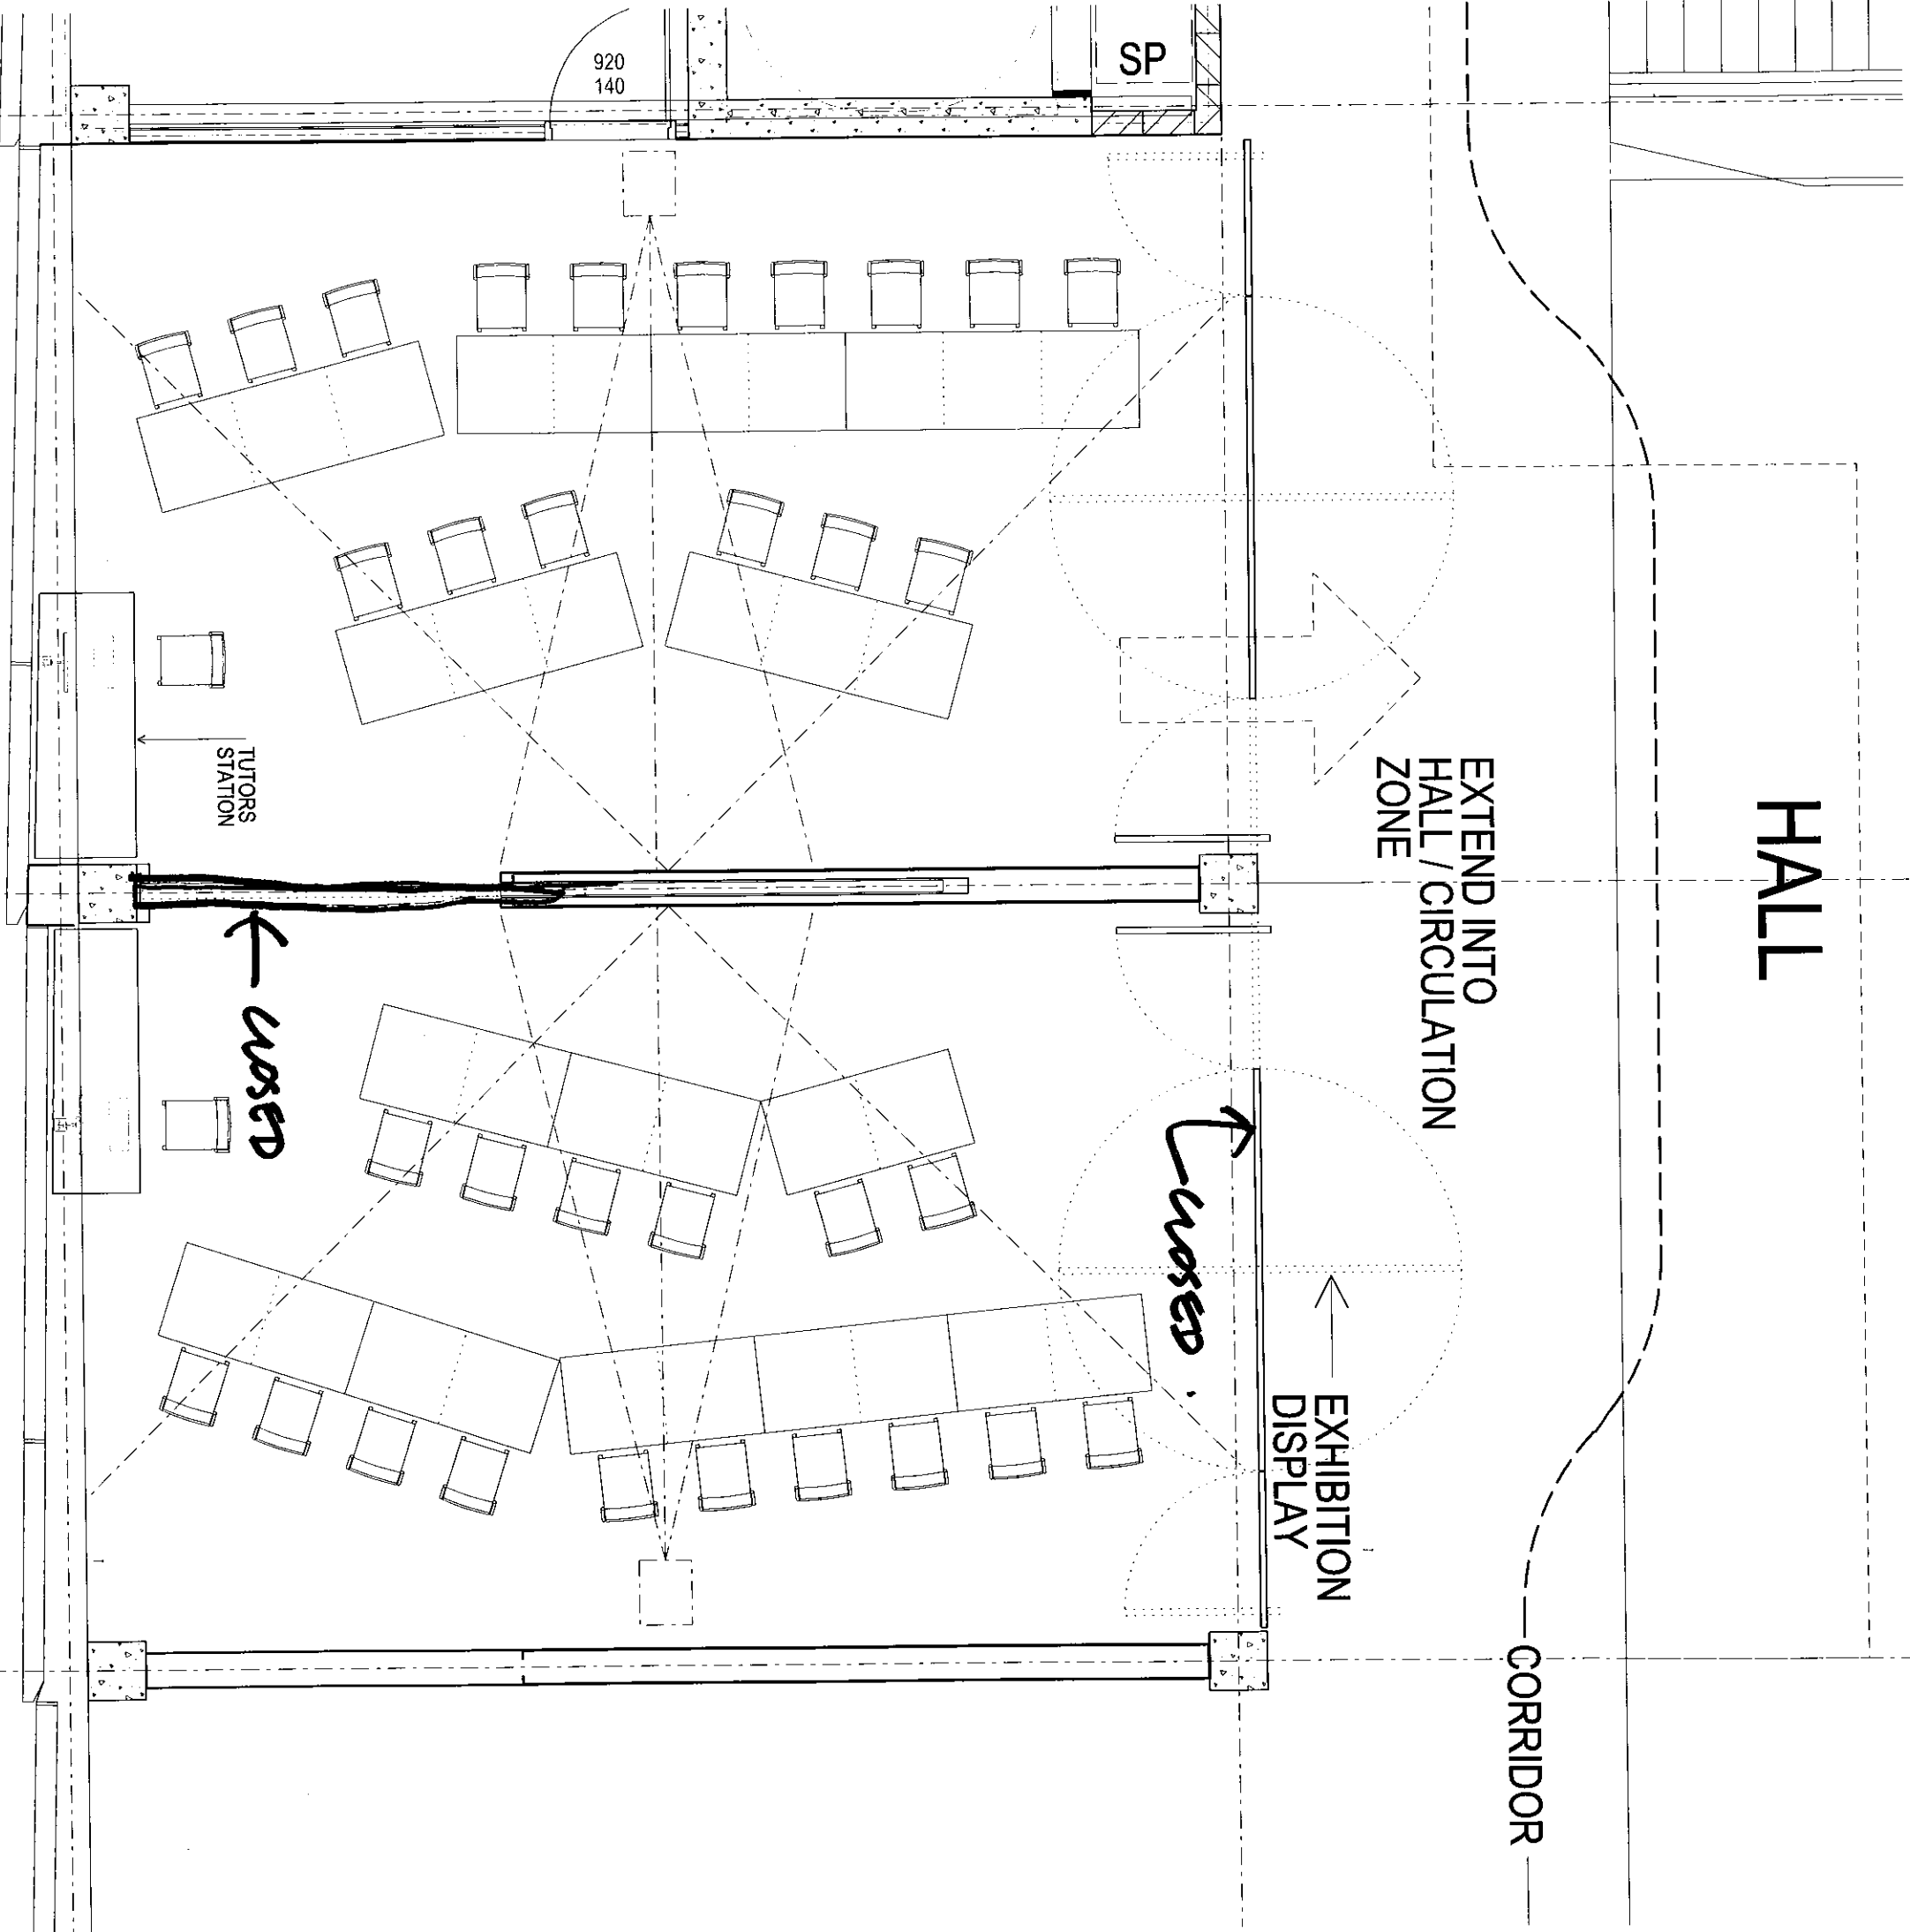

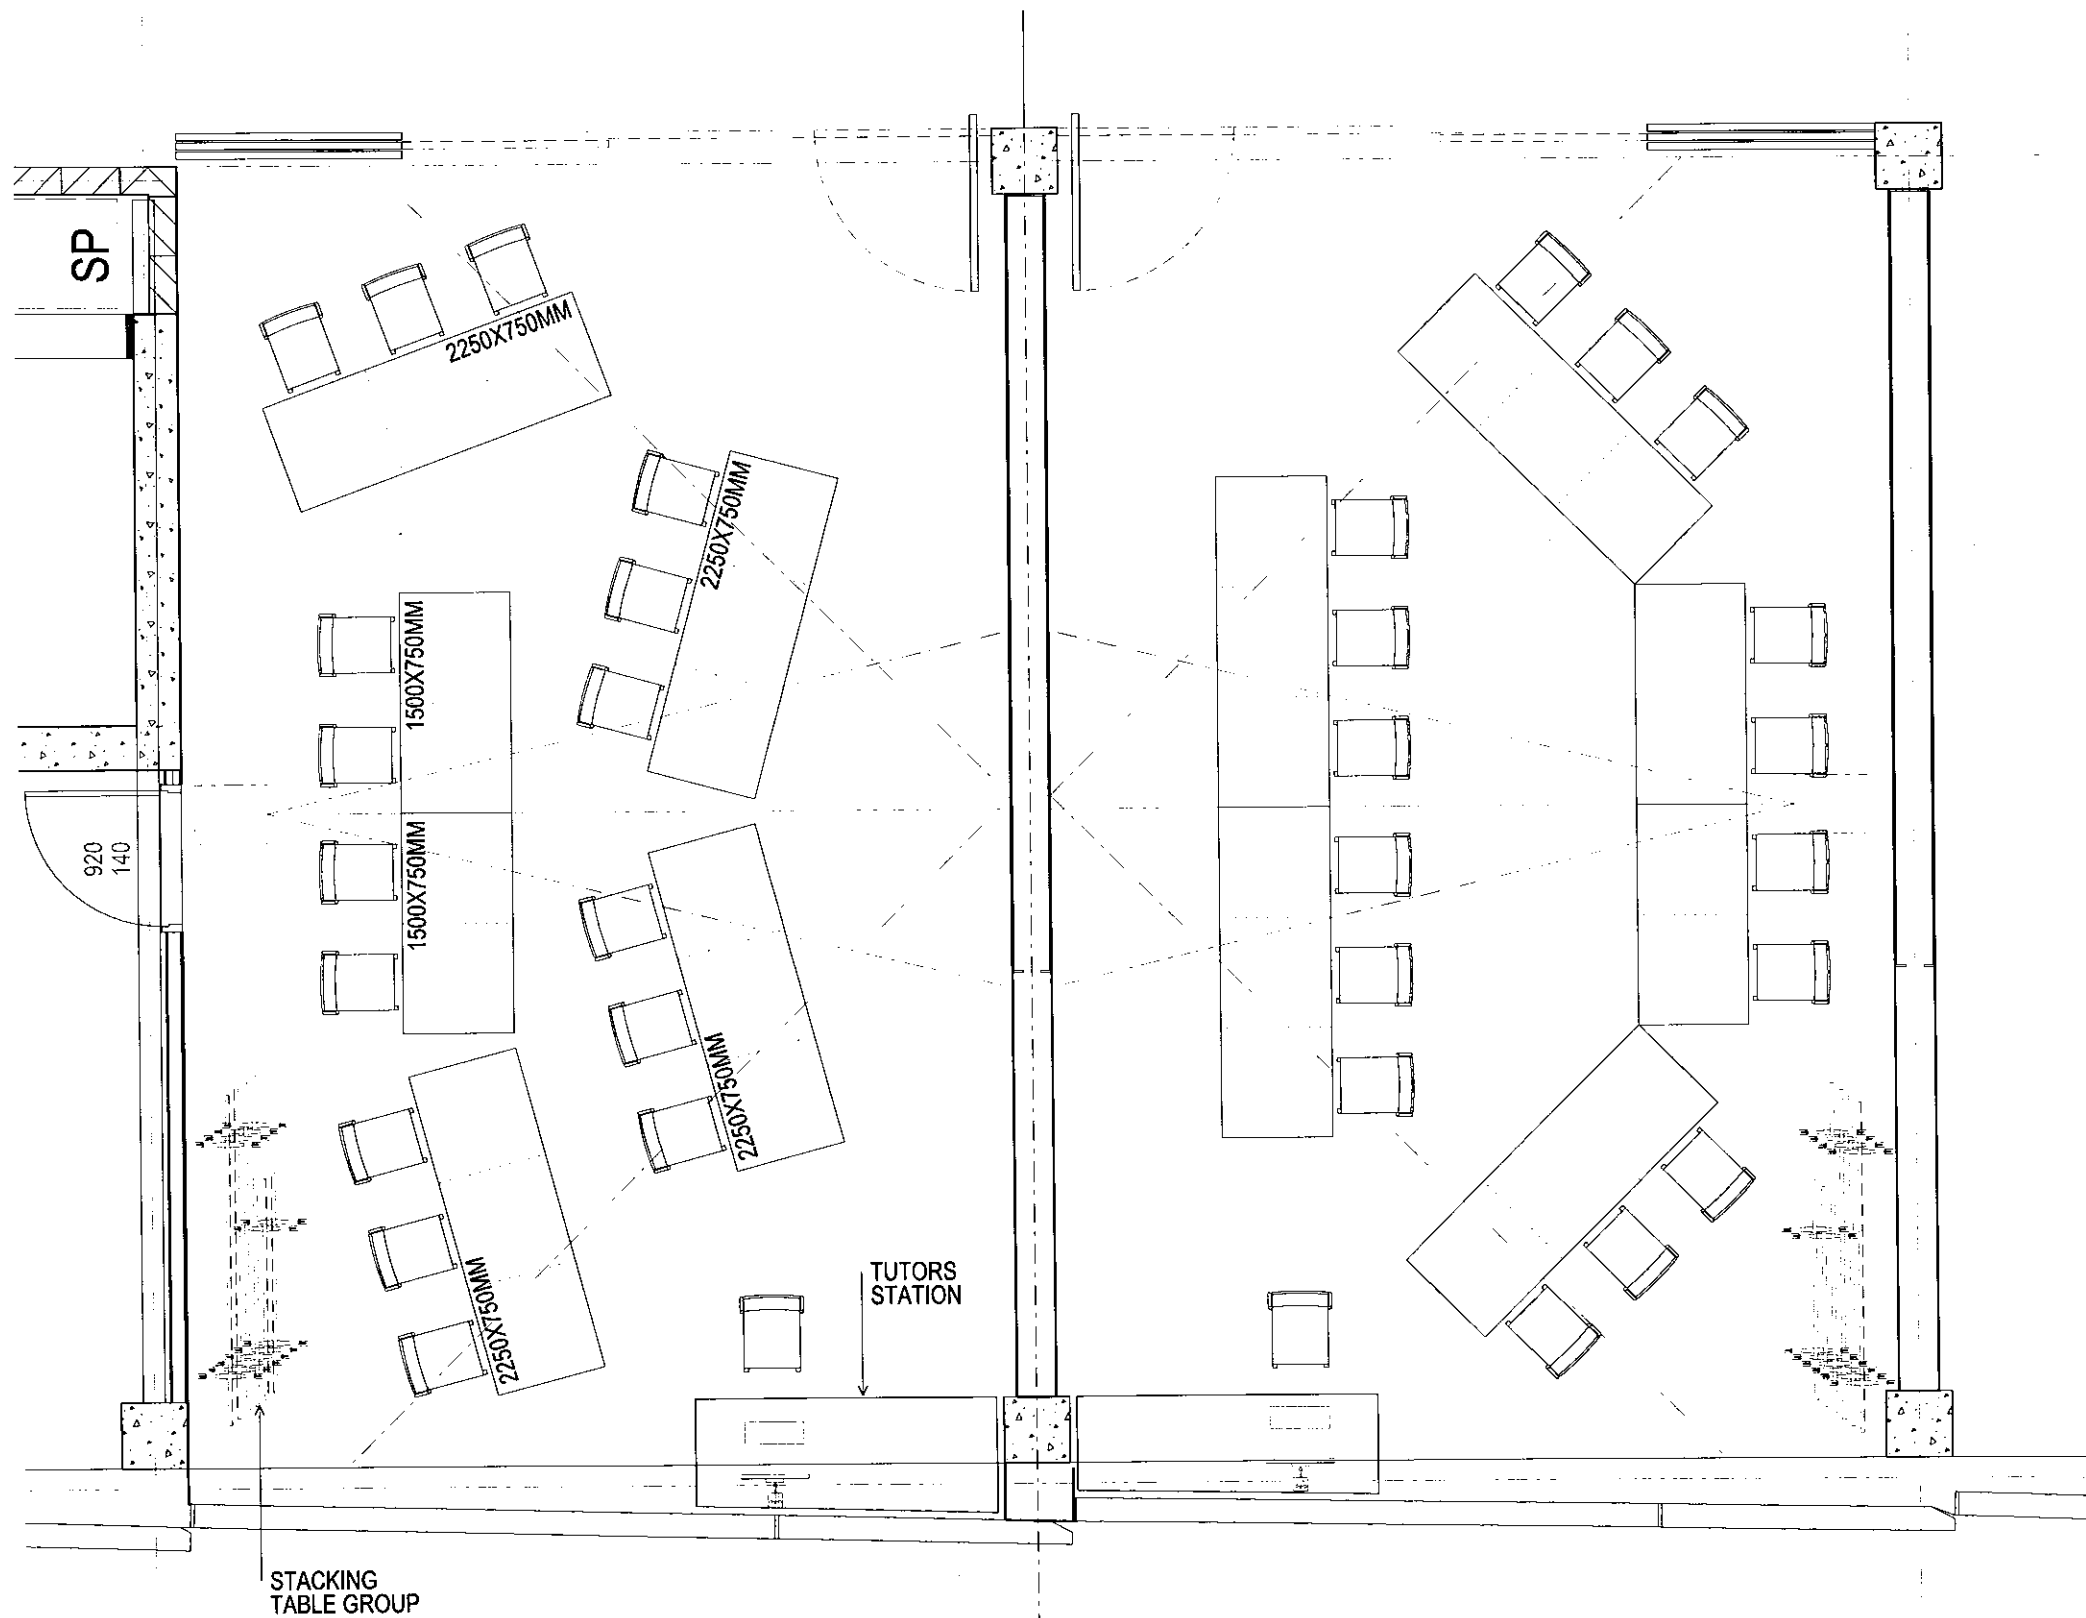


2250X750MM / 1500X750MM TABLES

9

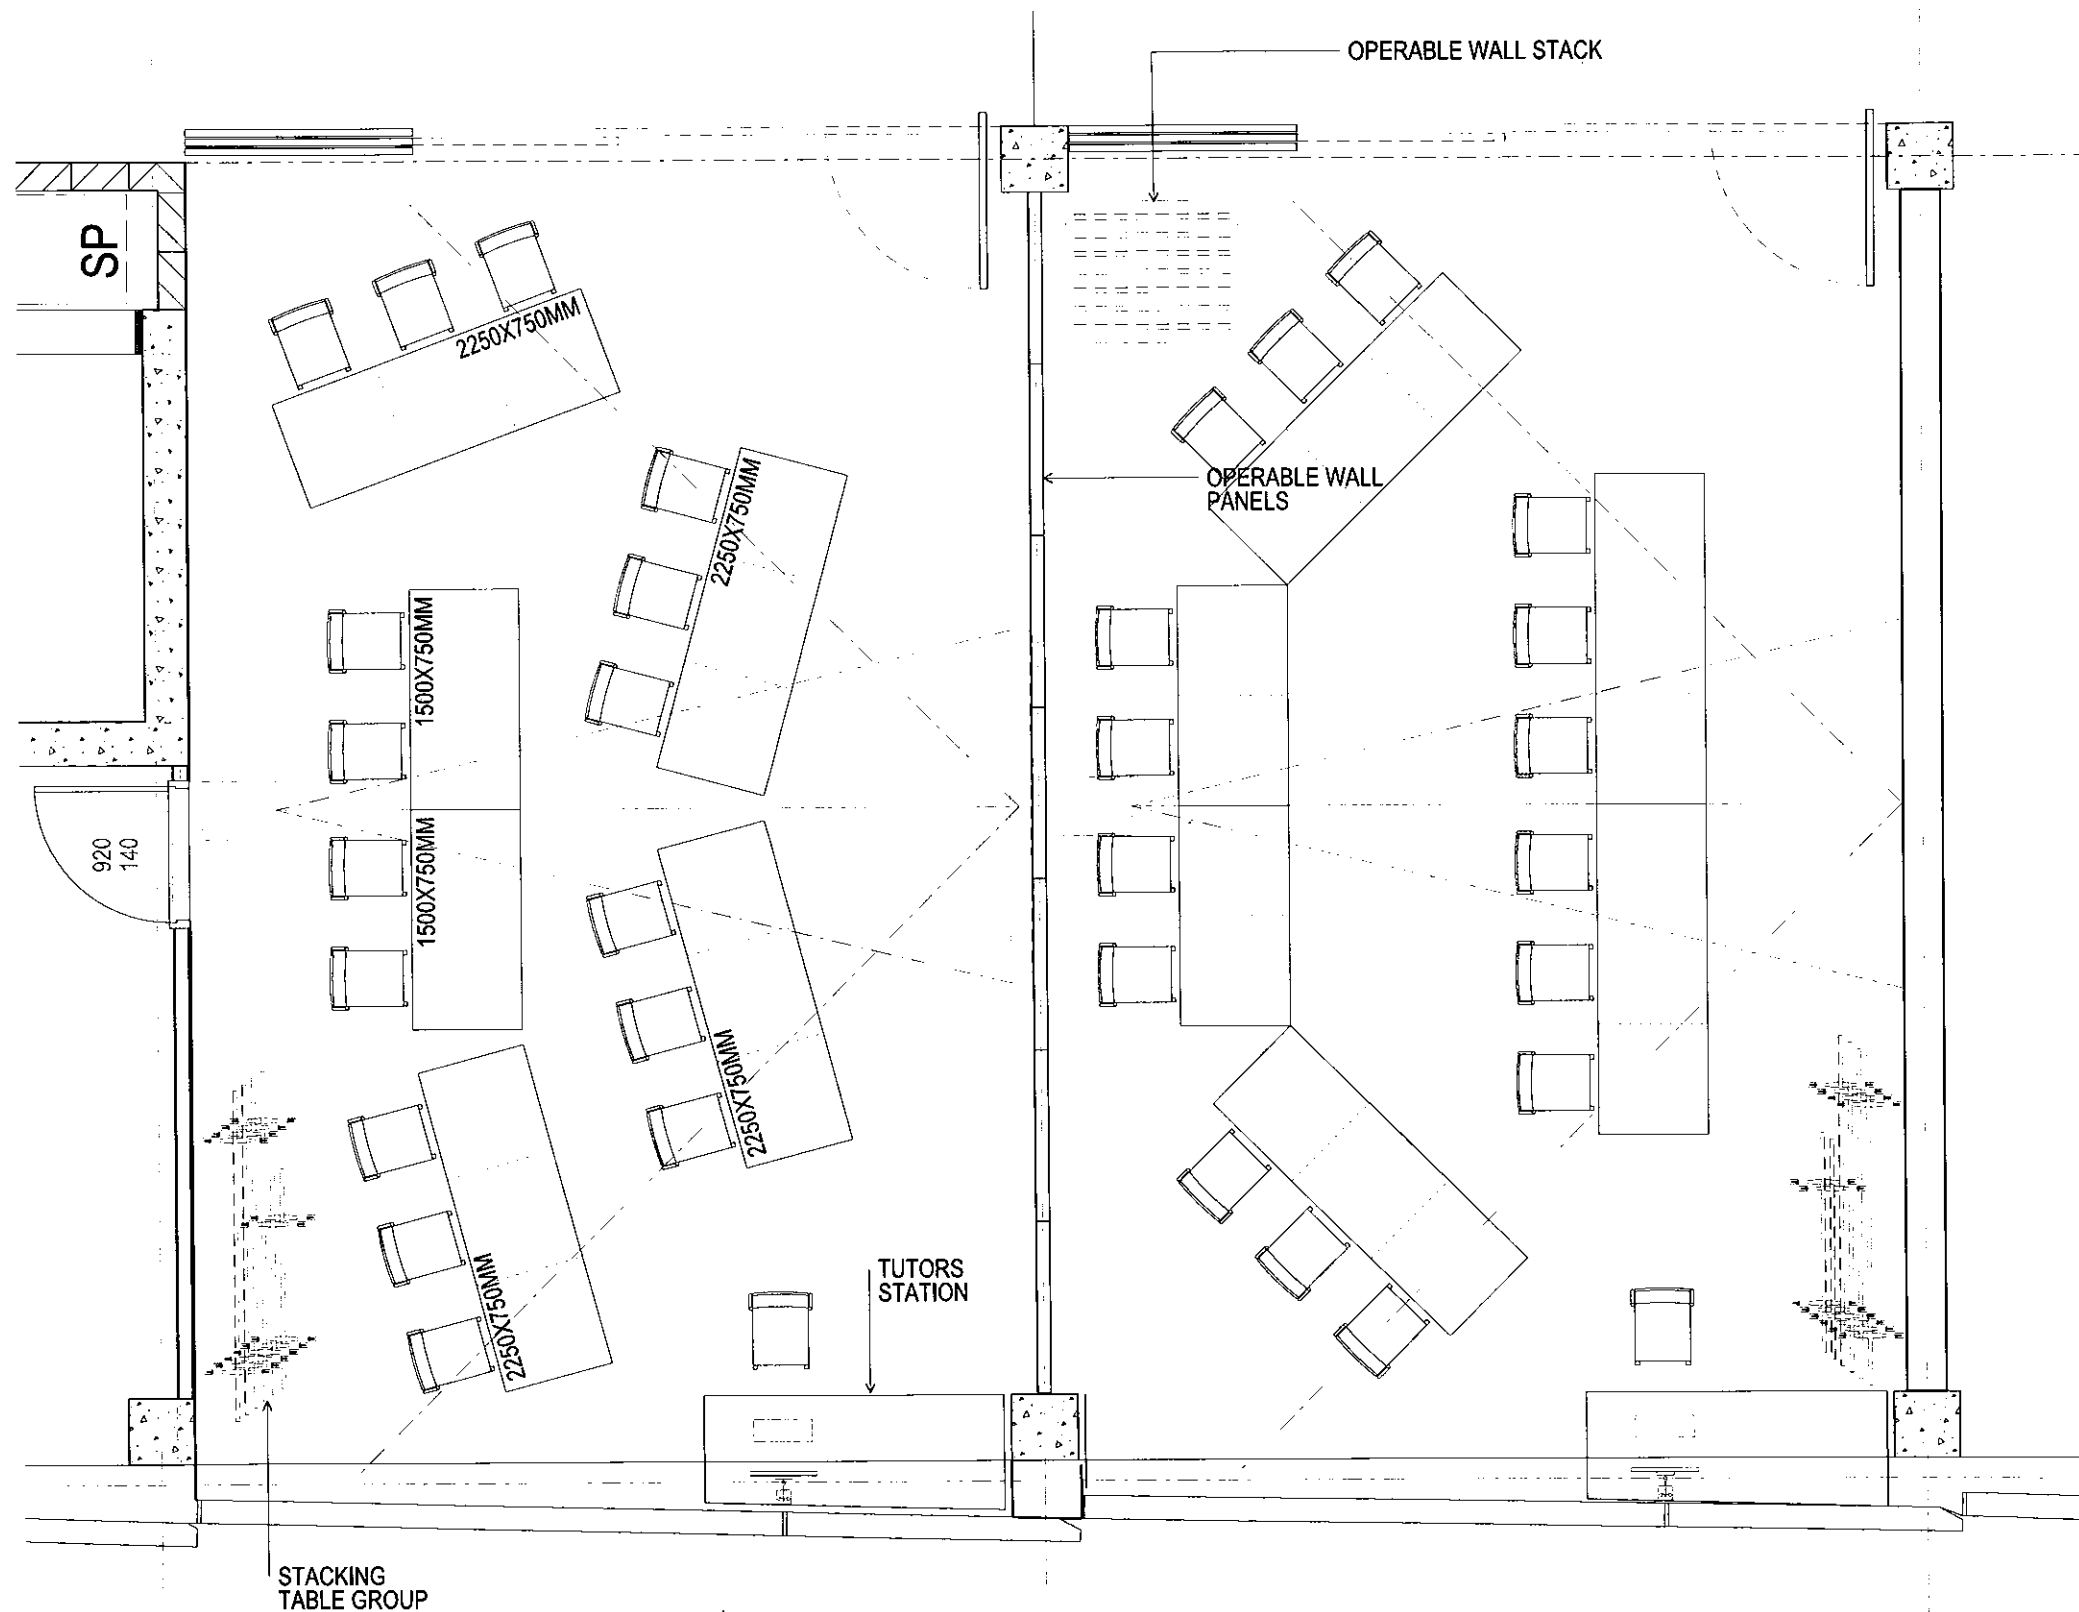


**2250X750MM / 1500X750MM TABLES
OPERABLE WALL**

10

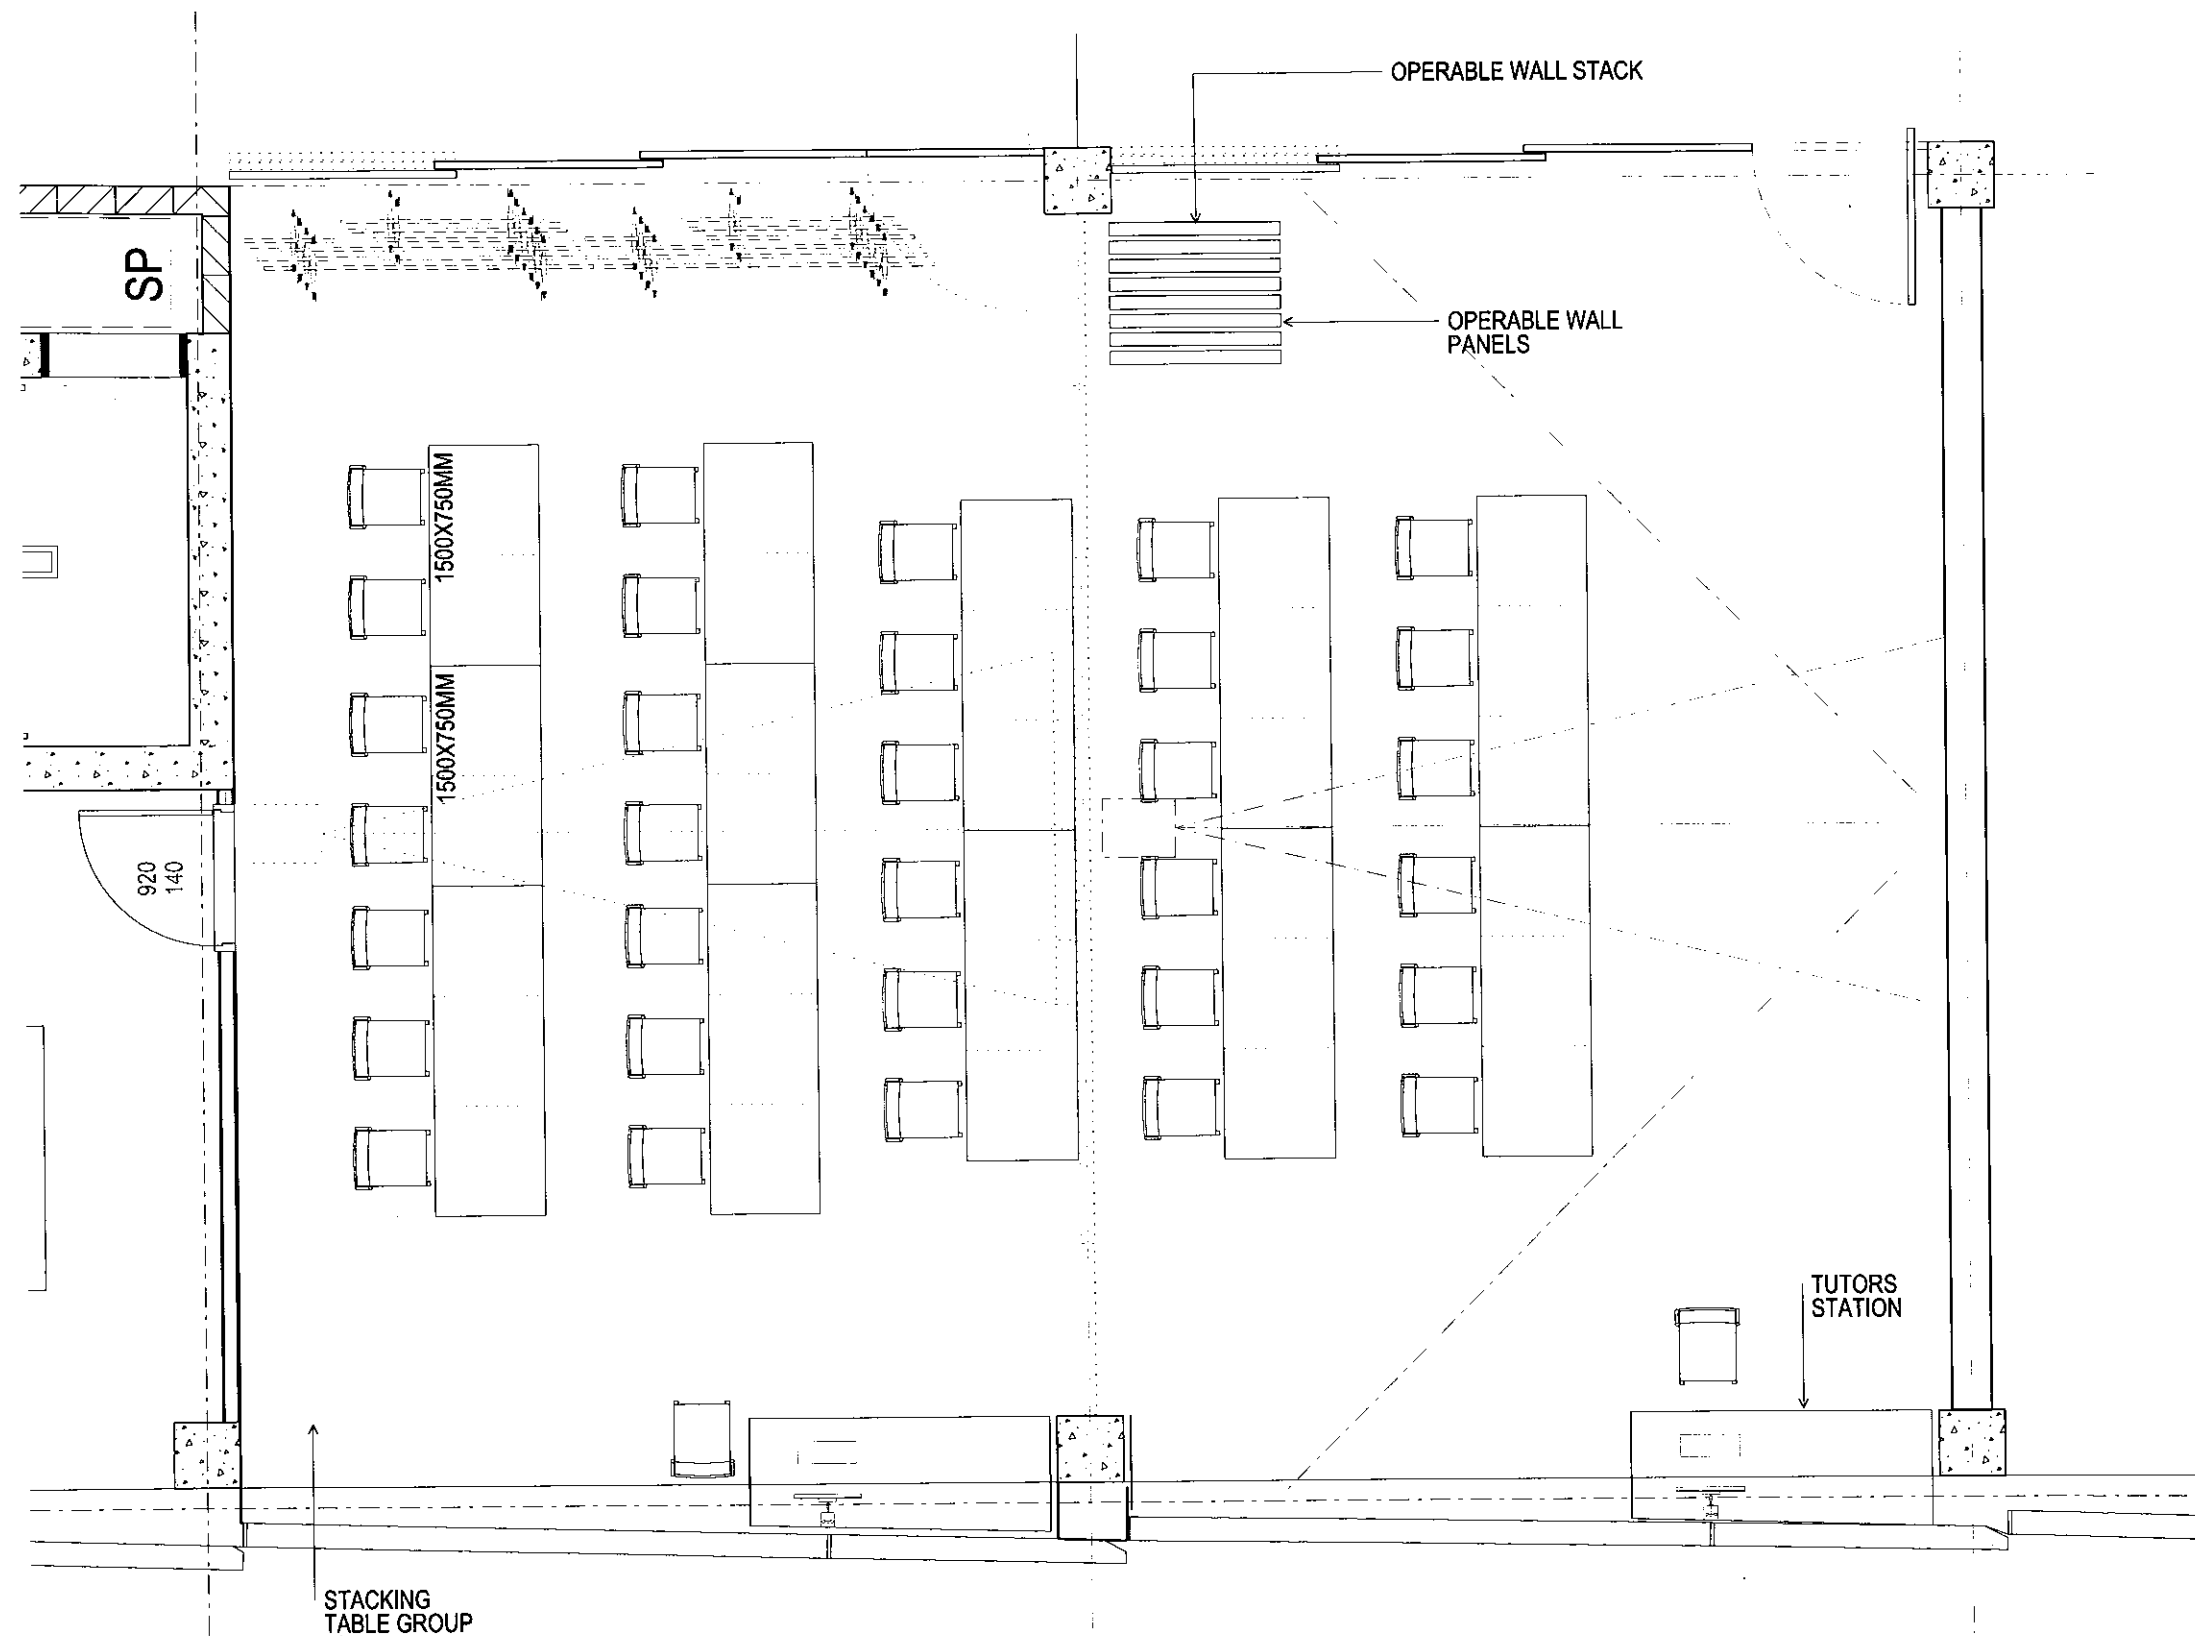


2250X750 / 1500X750MM TABLES
OPERABLE WALL - OPEN MODE

11

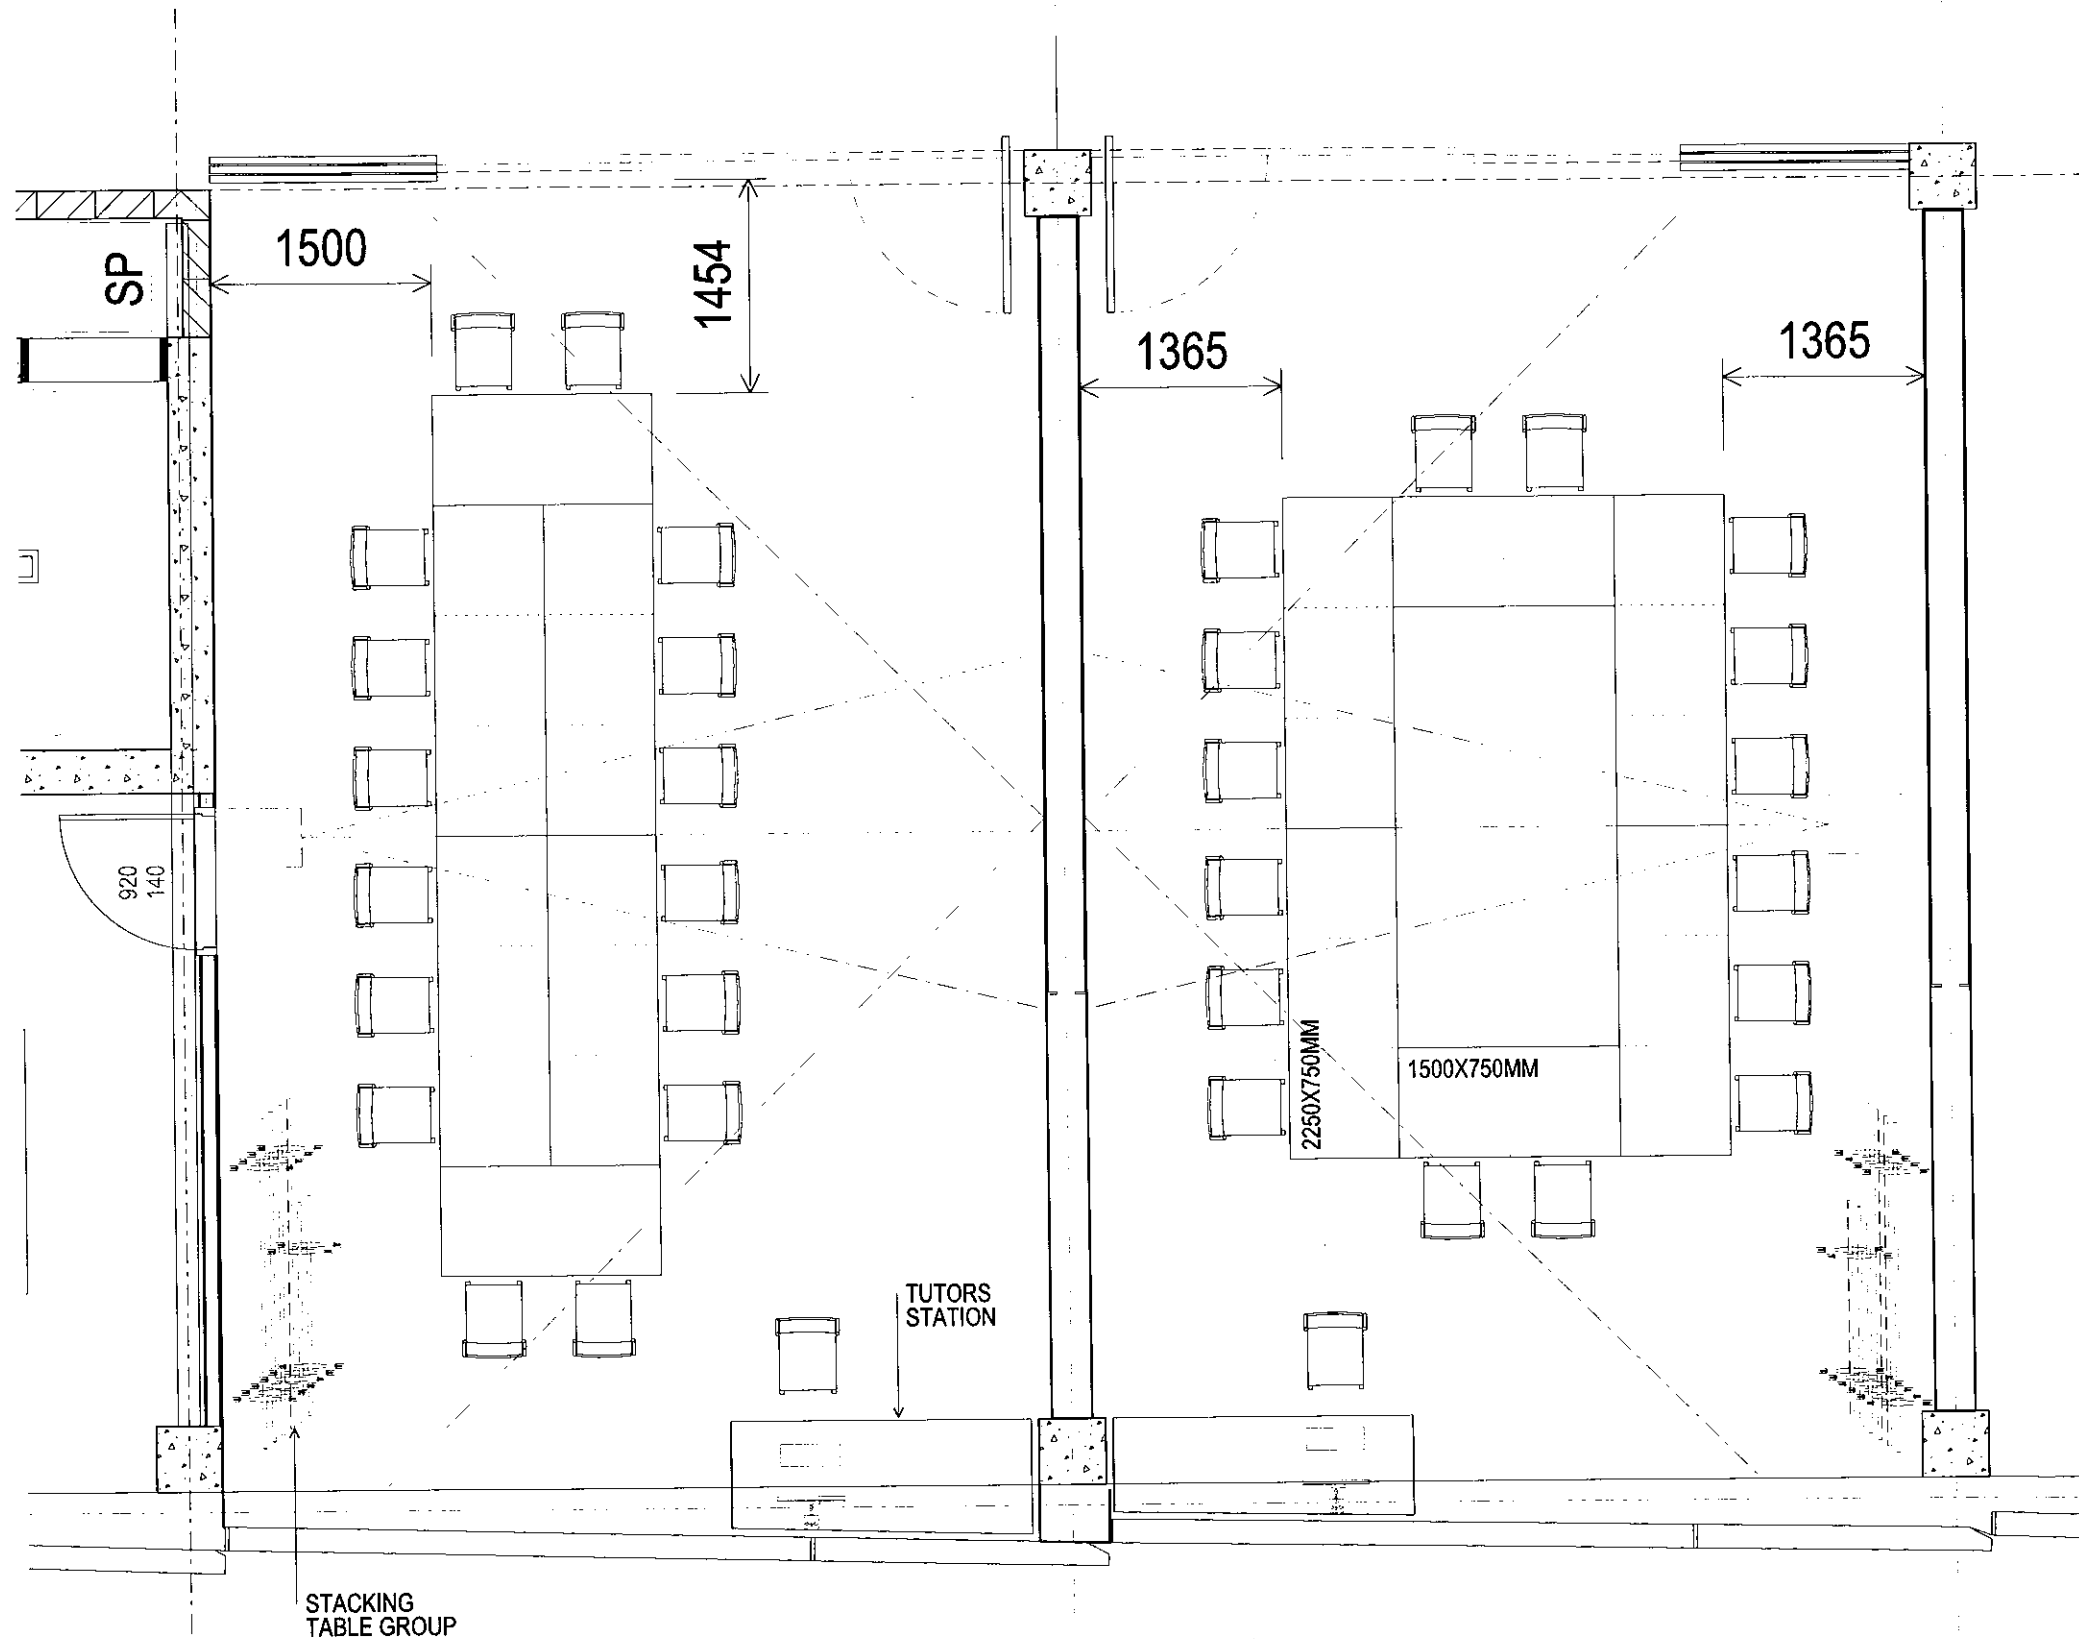

2250X750MM / 1500X750MM TABLES
FIXED WALL
CONFERENCE MODE

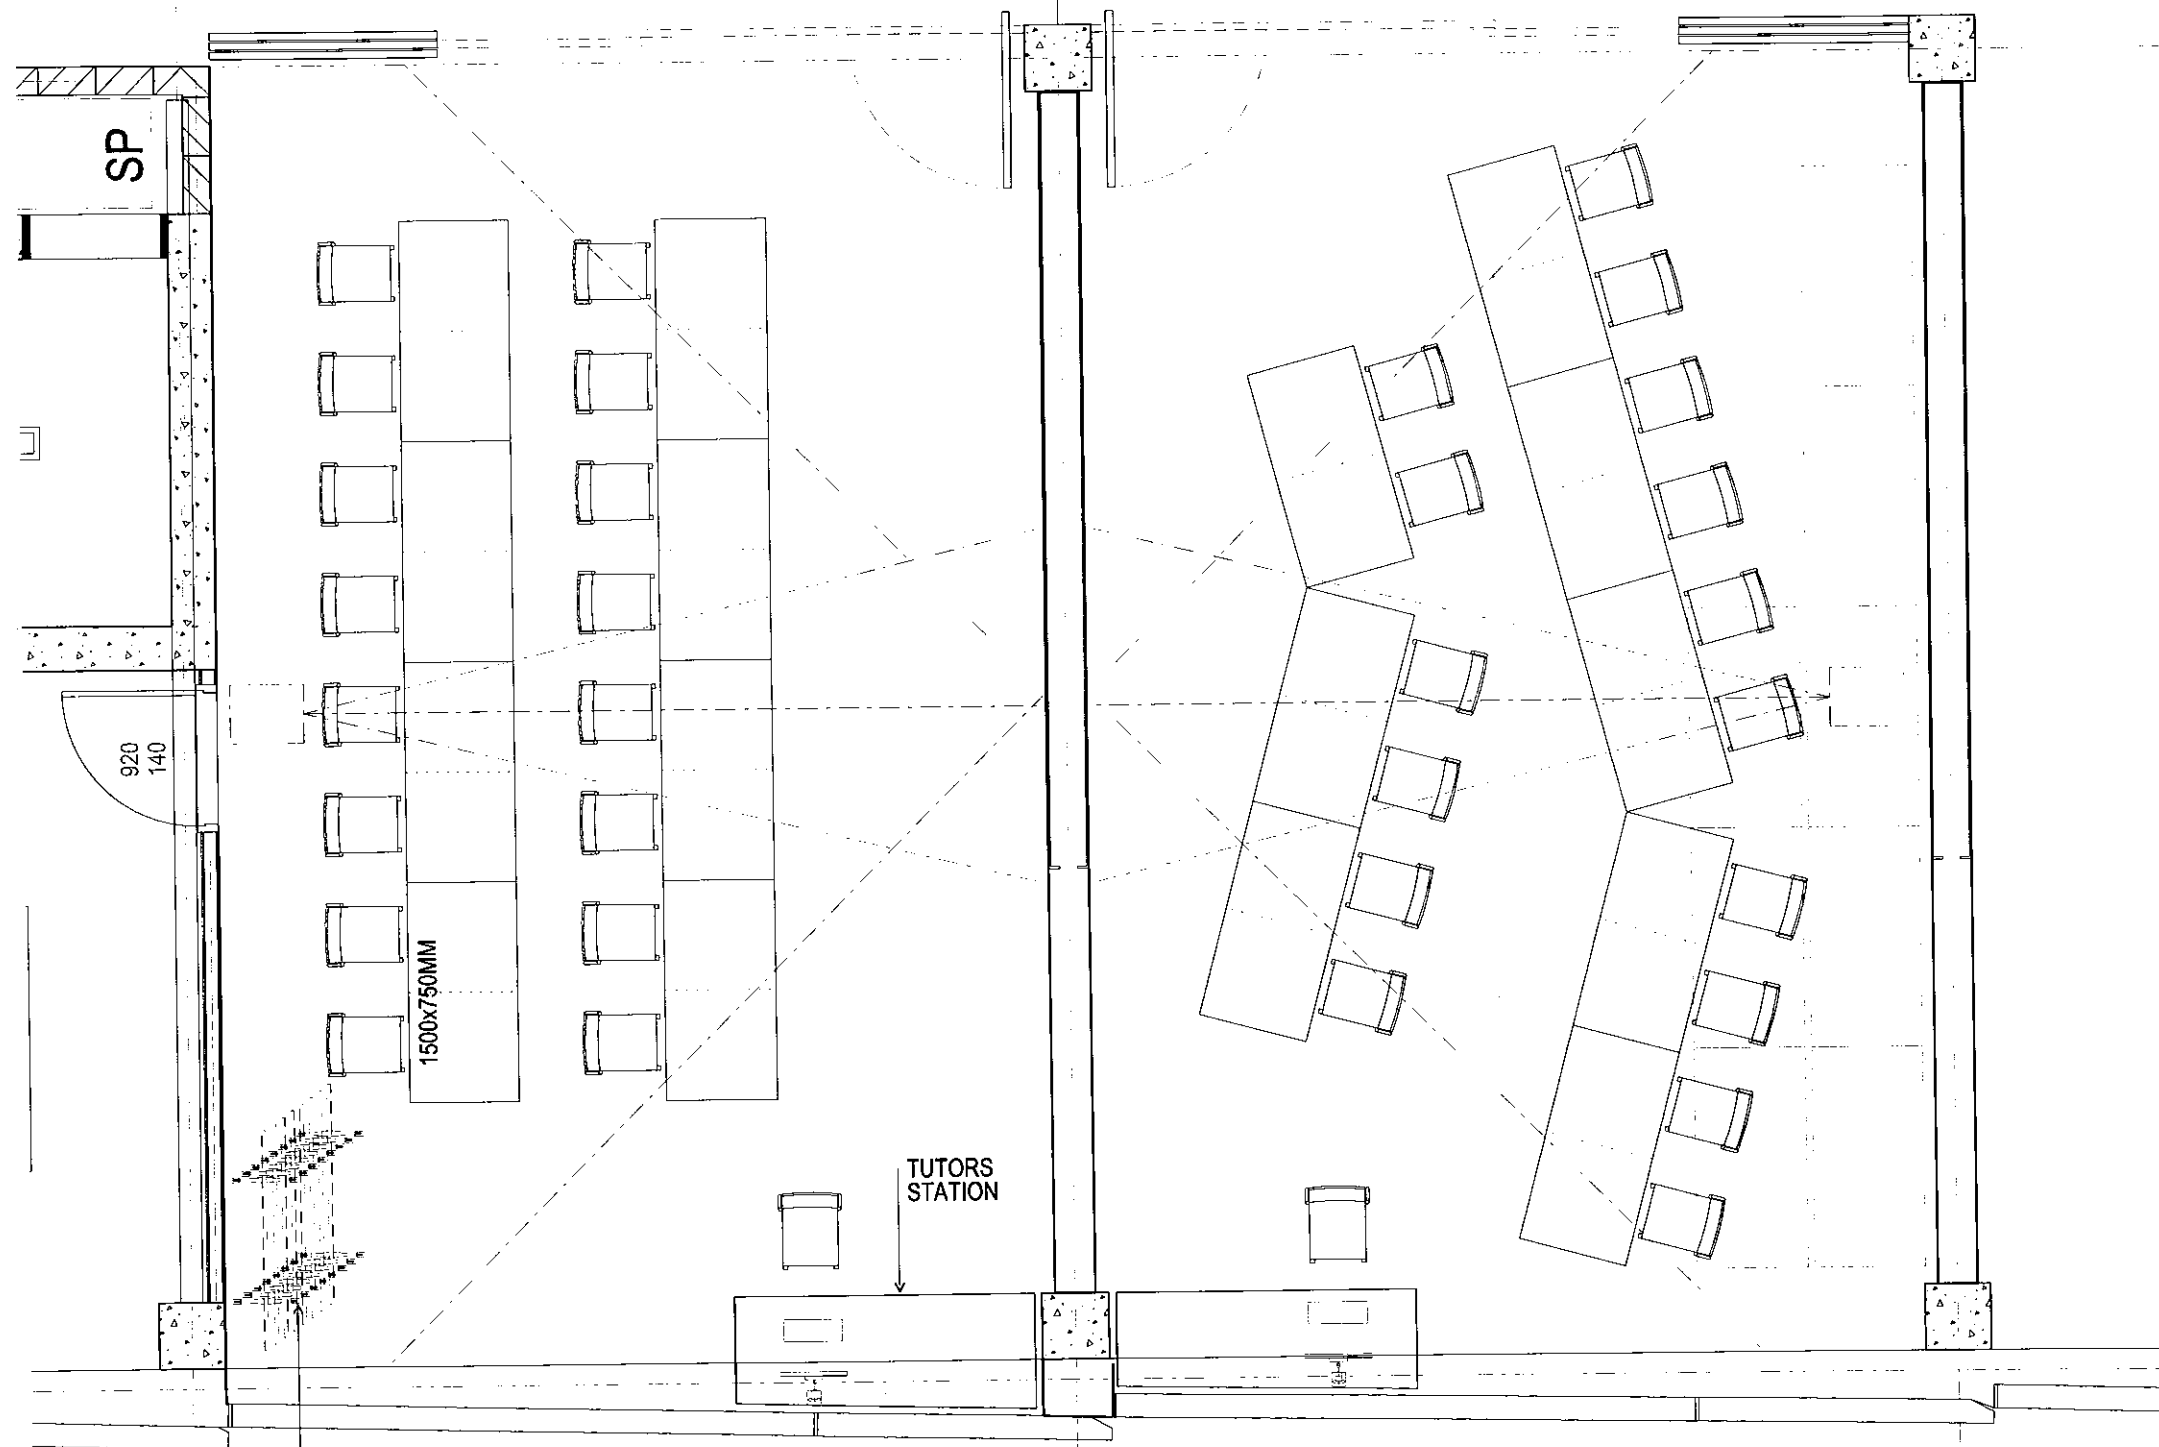

1500x750MM TABLES

13

14

ALL

Y&B
Y&B

CORRIDOI

LINKAGE TO
CARD CASE
EXTENDING
TO
HALL
CIRCULATION
ZONE

EXHIBITION
DISPLAY

OPEN UP WITH
SUBING PANEL
ABOVE DESK
HEIGHT.
FIXED INFRASTRUCTURE
REMAINS IN PLACE.

SP

920
140

COMPUTER LAB

1500X750MM TABLES
2250X750MM TABLES

