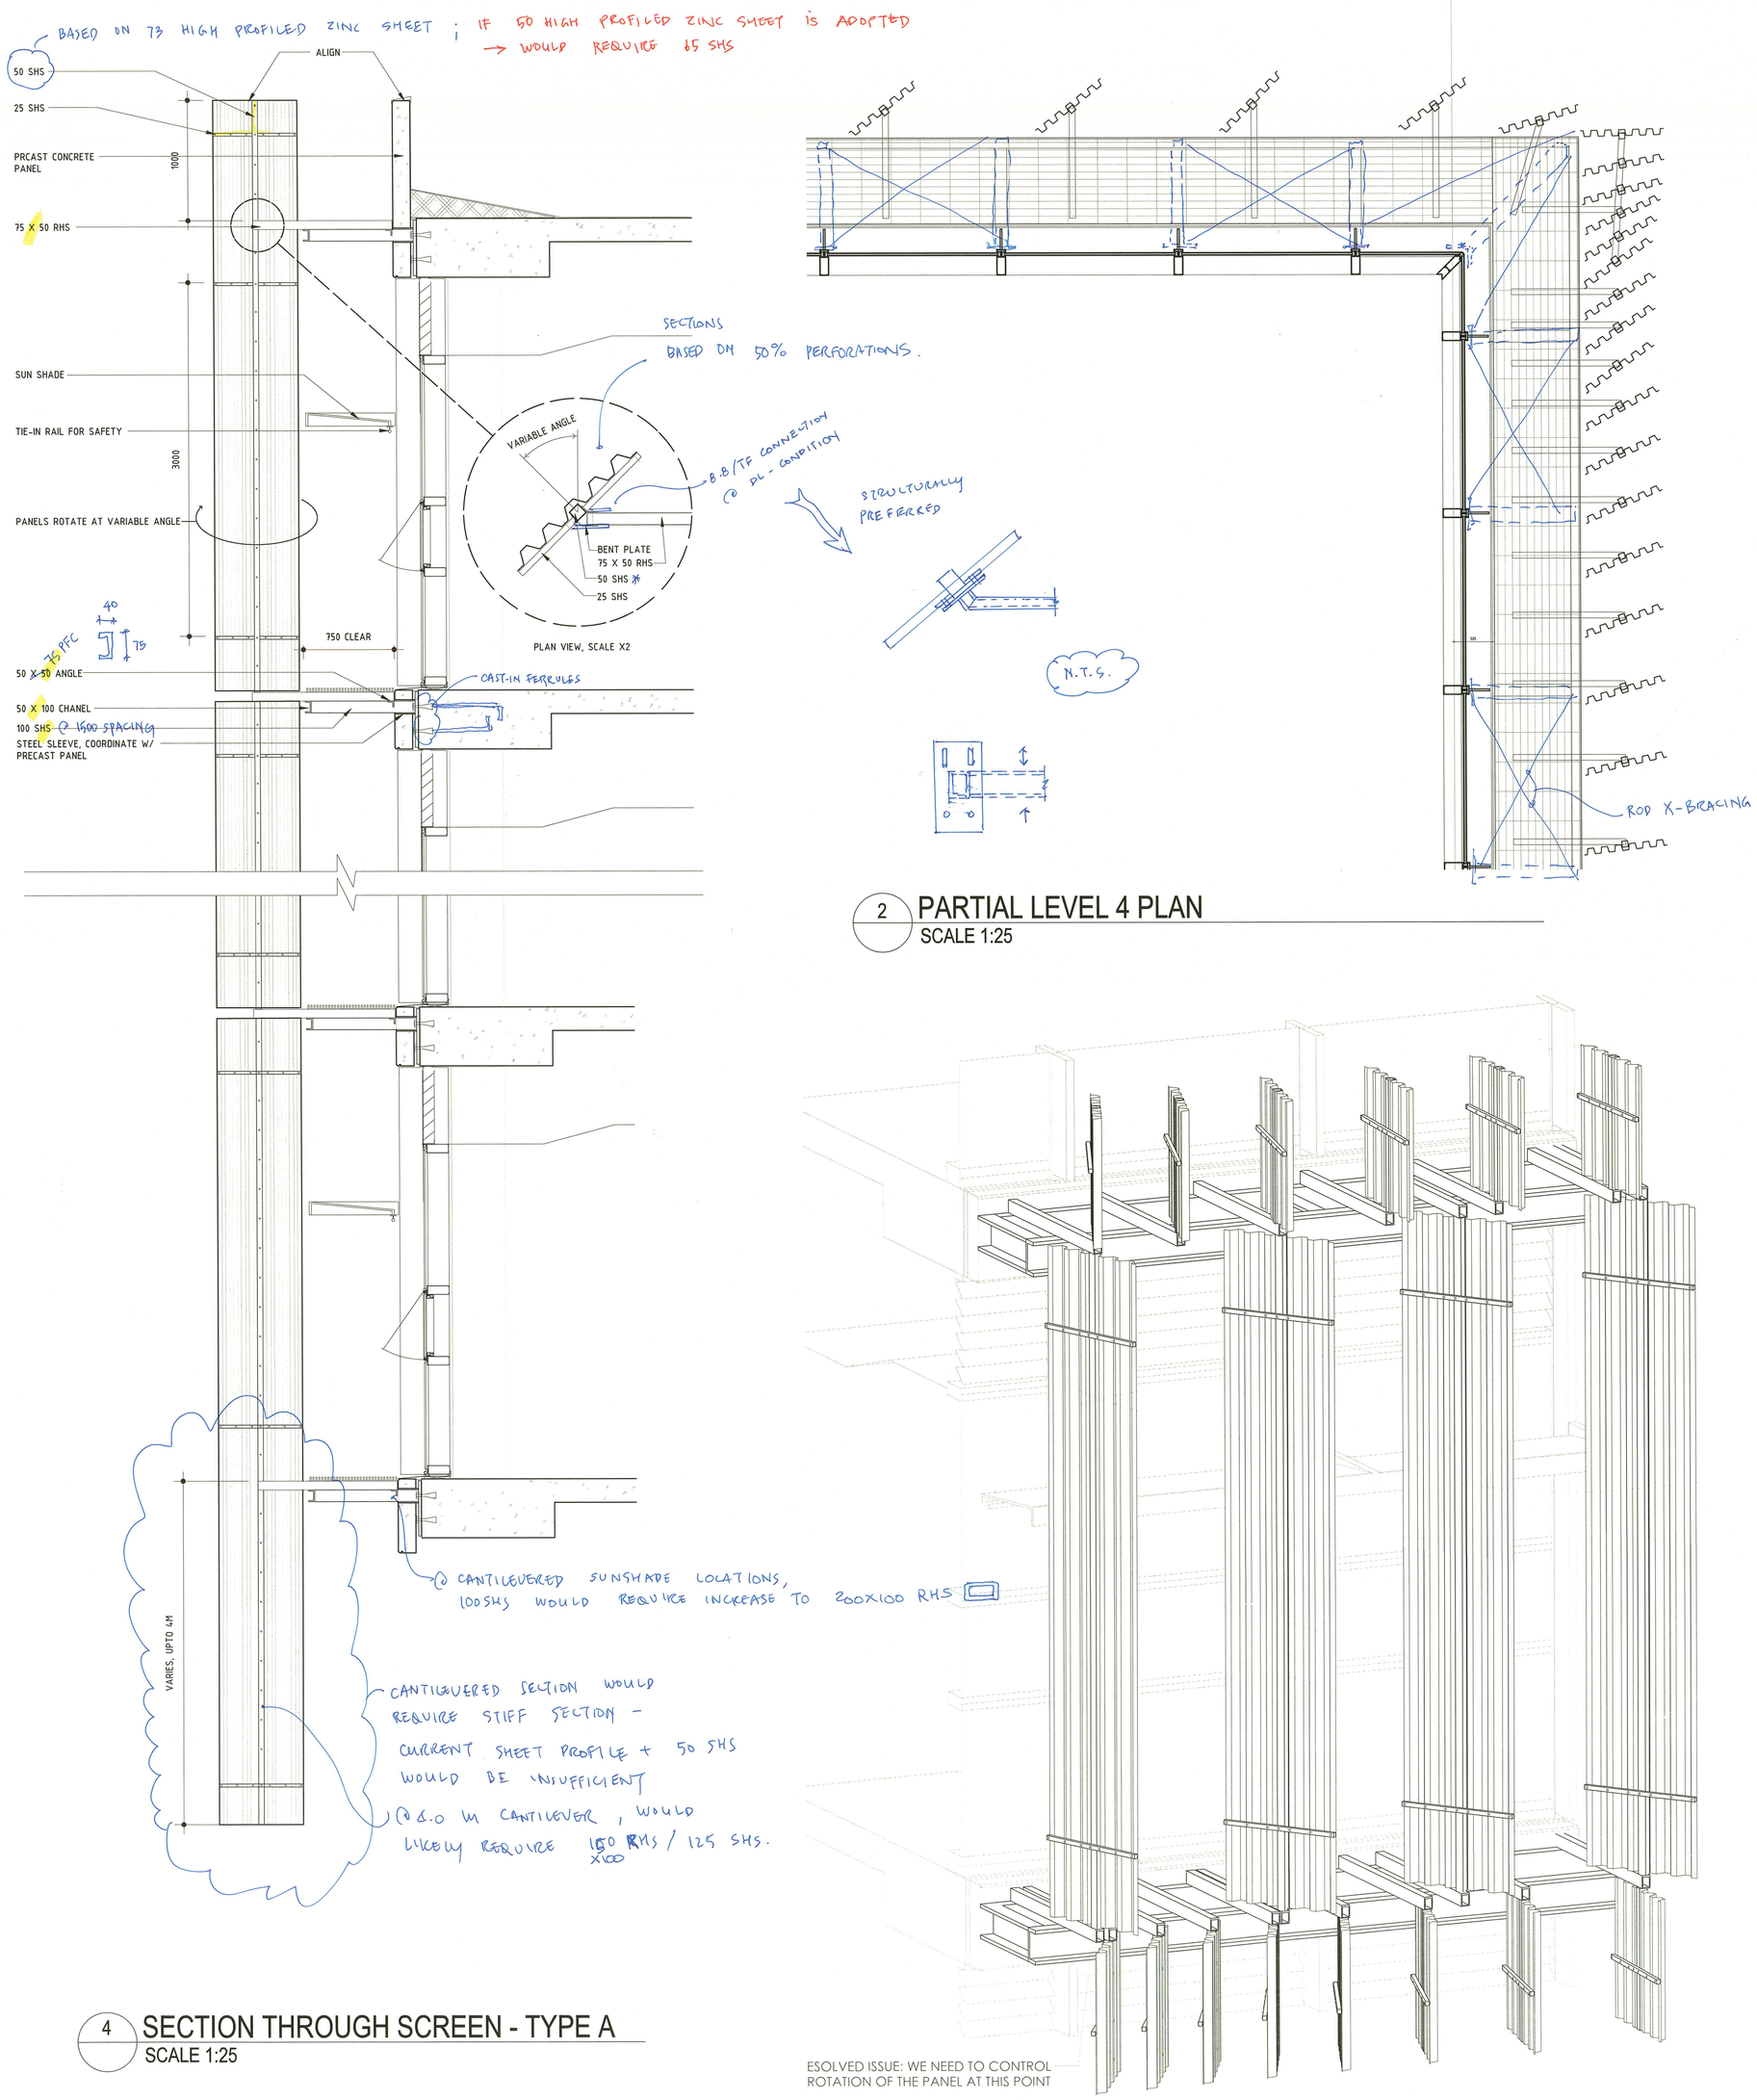

2 PARTIAL LEVEL 4 PLAN
SCALE 1:25

4 SECTION THROUGH SCREEN - TYPE A
SCALE 1:25

ESOLVED ISSUE: WE NEED TO CONTROL ROTATION OF THE PANEL AT THIS POINT

3 PERSPECTIVE VIEW OF SCREEN - TYPE A
SCALE N.T.S.

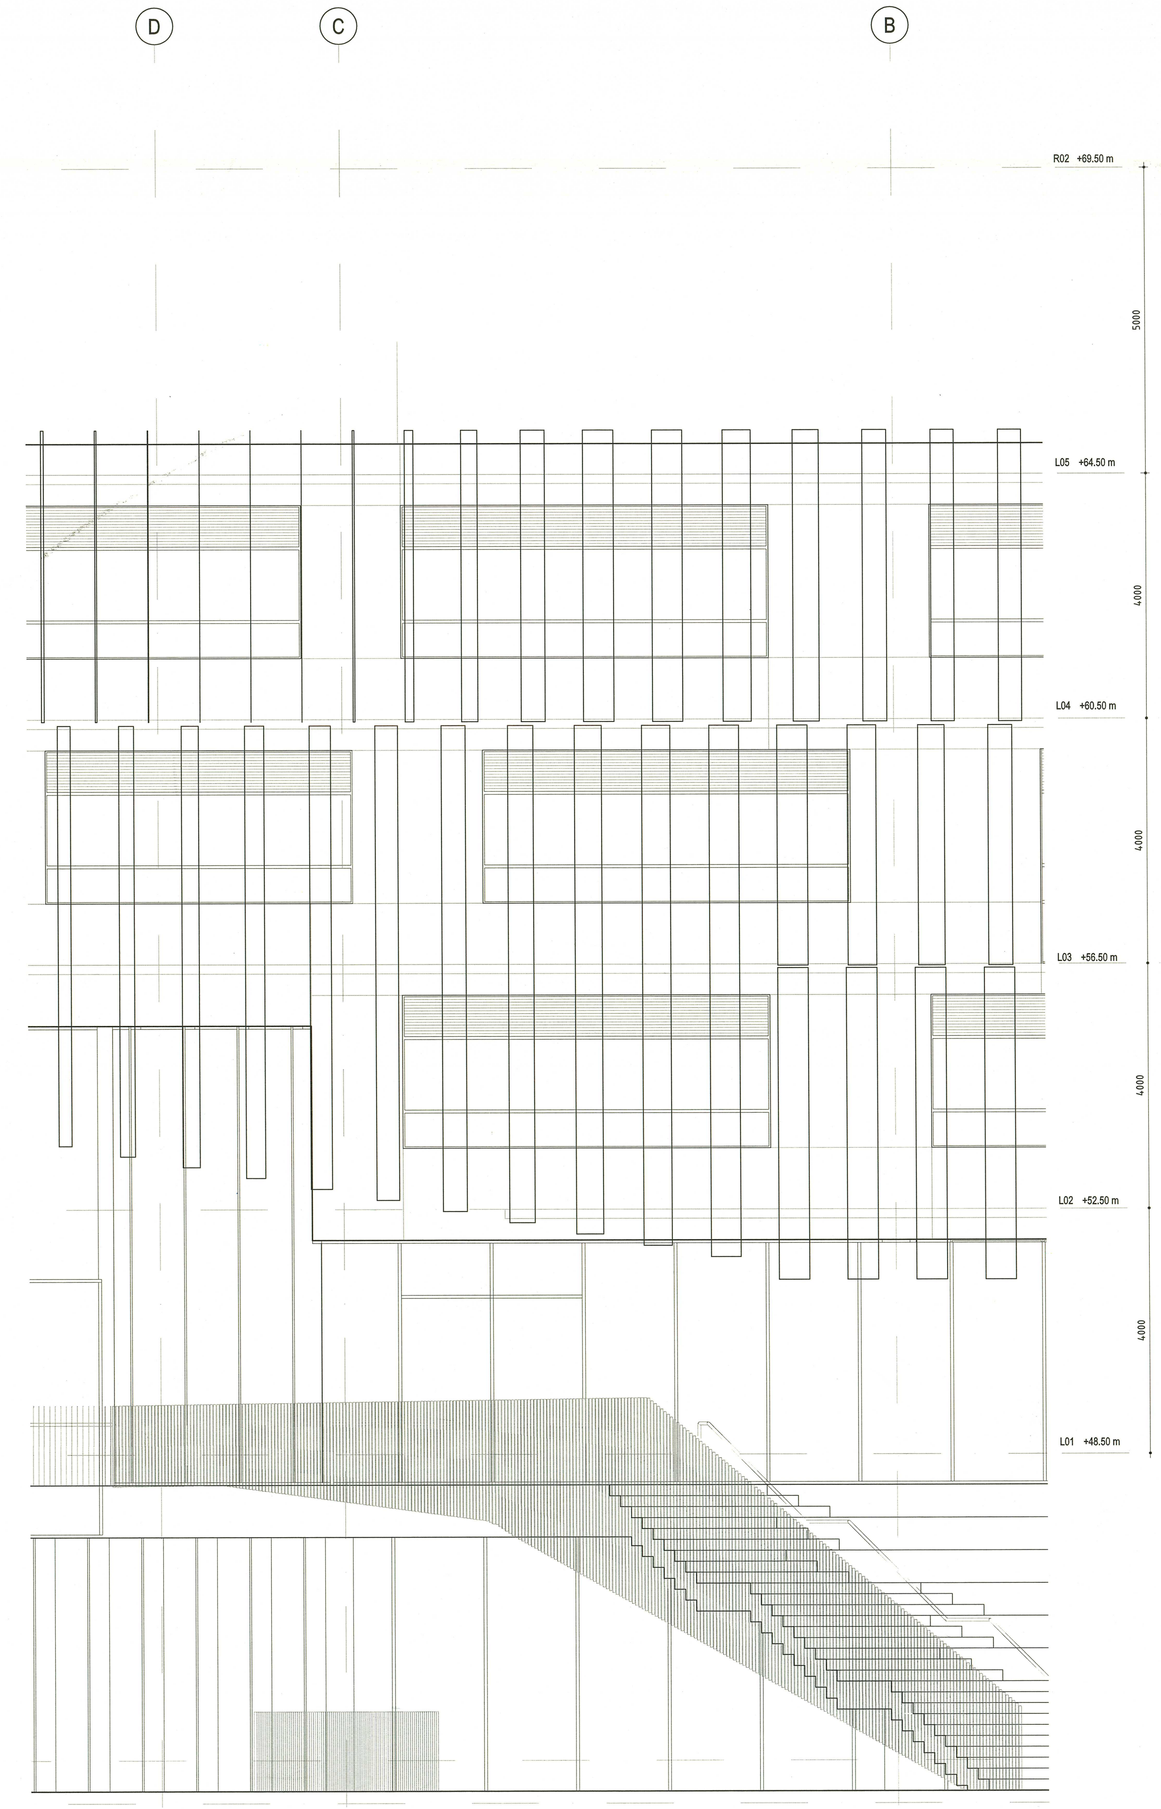

1 ELEVATION OF SCREEN -TYPE A
SCALE 1:50

THIS DRAWING IS AN UNCONTROLLED COPY UNLESS STAMPED OTHERWISE

CONTRACTORS SHALL VERIFY JOB DIMENSIONS BEFORE ANY JOB COMMENCES. ALL SHOP DRAWINGS SHALL BE SUBMITTED TO THE SUPERINTENDENT AND MANUFACTURE SHALL NOT COMMENCE PRIOR TO THE RETURN OF UNAMENDED SHOP DRAWINGS SIGNED BY THE CONSULTANT. FIGURED DIMENSIONS SHALL TAKE PRECEDENCE OVER SCALED. THIS DRAWING SHOULD BE READ IN CONJUNCTION WITH ALL RELEVANT CONTRACT, SPECIFICATIONS AND DRAWINGS COPYRIGHT OF THIS DRAWING IS VESTED IN WARDLE

General Notes

CONTRACTOR DOCUMENT REVIEW
☐ NO EXCEPTION TAKEN ☐ MAKE CORRECTIONS NOTED ☐ REVISE AND RESUBMIT
Acreage Australia Pty Ltd
ACN 088 109 879
By WCC
Date 225219.001
Project No. 17.11.11
Date received 17 NOV 2011
This review is only for general conformance with the design concept of the project and general compliance with the information given in the contract documents. Any design effect is subject to the requirements of the relevant authorities.
It is the sole responsibility of the Contractor to fully coordinate structures and of his responsibility of ensuring this work is complete, accurate & error free.
Any amendment must not contravene or be in substitute for a prior approval.

Rev	Issue	Revision Description	Amd	Date
02	JC	PRELIMINARY DD ISSUE	-	28.10.11
01	JC	PRELIMINARY DD ISSUE	-	07.10.11

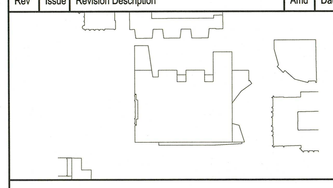

NADAAA
NADAAA
1920 Washington Street No.2
Boston Massachusetts 02118 USA
Telephone +1 617 442 6232
Facsimile +1 888 442 1417
Email nada@nadaaa.com

John Wardle Architects

© 2011 John Wardle Architects
Level 10, 180 Russell Street, Melbourne Victoria 3000 Australia
Tel : +613 9654 8700 www.johnwardlearchitects.com

Client: University of Melbourne Parkville Campus

Project: Faculty of Architecture Building and Planning

Title: Screen Details - Type A

Project No. 0913		Scale AS SHOWN	
Drawing No. AR6180		Revision 01	
Date May 2011	Drwn -	Co-Ord -	Chck -

FILENAME - $FILE$

PRELIMINARY ISSUE